IREDELL COUNTY HEALTH DEPARTMENT

STATESVILLE 704-878-5305 (ar) MOORESVILLE 704-664-5281

IMPROVEMENT PERMIT / AUTHORIZATION TO CONSTRUCT / OPERATION PERMIT / EXISTING SYSTEM INSPECTION

PERMIT # 15980 PIN # 4707244371 DATE 3-2-10

OWNER or APPLICANT Peter Cowart PHONE: Business Home: 704-838-0512

OWNER or APPLICANT ADDRESS 149 Cowart Drive Statesville, NC 28625

LOCATION / DIRECTIONS North to old Mocksville Rd (R) Cowart Past Barn up hill

SUBDIVISION BLOCK / SECTION LOT # LOT AREA 1/0.5 DESIGN FLOW 360 L.T.A.R. .125

Septic Tank 1000 Gallons: STB 1012 Date 1-12-48

Pump Tank Gallons: P T Date

Pump Make Model Serial #

Nitrification Field No Fields 1 No Lines 4 Linear Feet 360

Trench Width 36" Trench Bottom Depth 36" Gravel Depth

☑ New System ☐ Repair ☐ Expansion System Type I II (III) IV V VI

System Description: 25% Graunt

Repair System Description: 50% Graunt

Maintenance Agreement Required ☐ YES ☑ NO

☑ GRAVITY ☐ PRESSURE

☑ Residence No. Bedrooms 3

☐ Business No. Persons

☐ Other No. Employees

☐ Slab ☑ Crawl Space

☐ Basement w/plumbing ☐ Basement w/o plumbing

Water Supply: ☐ Private ☑ Public ☐ Community


Comments / Conditions

Comments / Conditions

★ Install on Contour

★ Lines Must be 36" deep

INITIAL SITE SKETCH

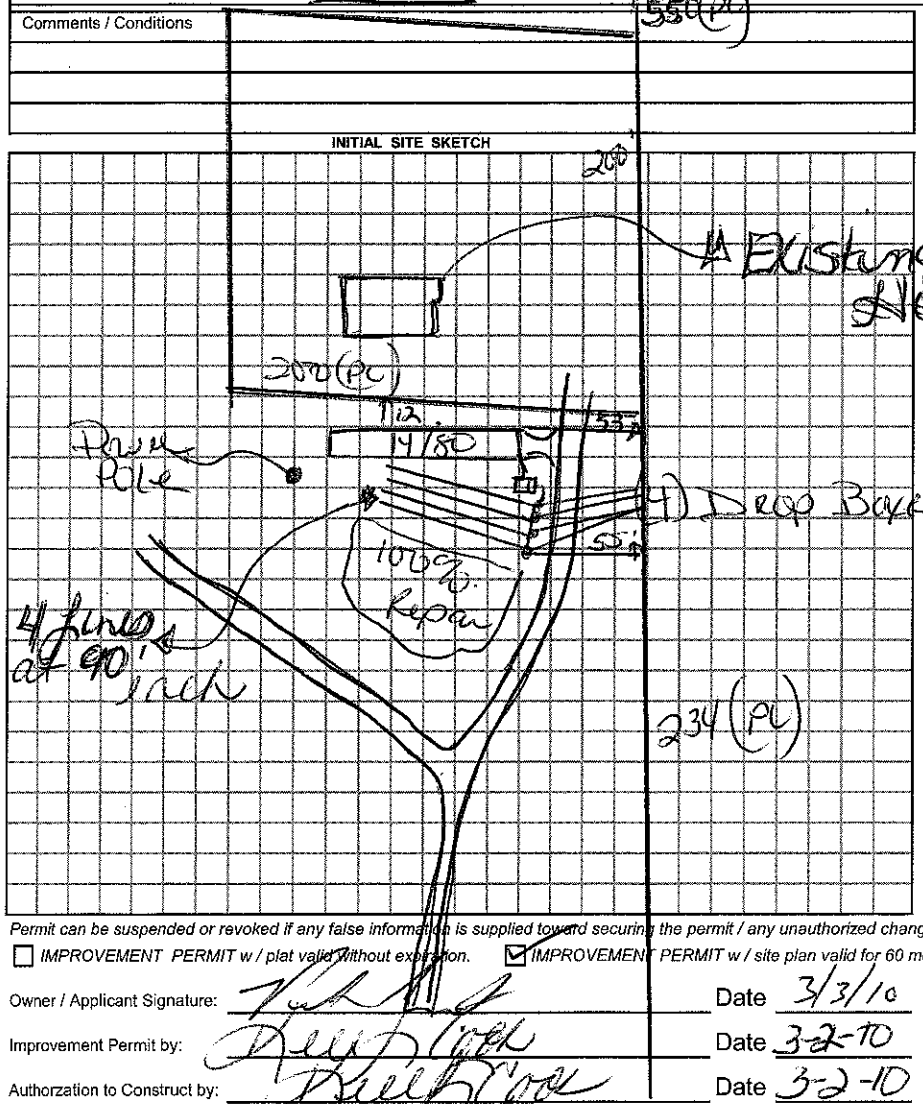

AS BUILT SKETCH

(NOT to SCALE)

Red Lab Site

Septic Made

Permit can be suspended or revoked if any false information is supplied toward securing the permit / any unauthorized changes are made to the site / any unauthorized changes are made in the installation of the system.

☐ *IMPROVEMENT PERMIT w / plat valid without expiration.* ☑ *IMPROVEMENT PERMIT w / site plan valid for 60 mos.* ☑ *AUTHORIZATION TO CONSTRUCT valid for period equal to IMPROVEMENT PERMIT-not to exceed 60 mo.*

Owner / Applicant Signature: Date 3/3/10

Improvement Permit by: Date 3-2-10

Authorization to Construct by: Date 3-2-10

Installed by: Curtis Gaddy

Operation Permit by: Date: 3-10-10

Existing System Inspected by: Date:

YOU SHOULD CONTACT A LOCATOR SERVICE PRIOR TO ANY EXCAVATION.

WHITE COPY Environmental Health YELLOW COPY (Final) Owner / Applicant PINK COPY (Initial) Owner / Applicant