IREDELL COUNTY HEALTH DEPARTMENT

STATESVILLE 704-878-5305 MOORESVILLE 704-664-5281

IMPROVEMENT PERMIT / AUTHORIZATION TO CONSTRUCT / OPERATION PERMIT / EXISTING SYSTEM INSPECTION

PERMIT# 091251 PIN# 4767254695

OWNER OR CONTRACTOR Larry Gruder DATE August 15, 2000

ADDRESS 317 Dunlap Gate Road Statesville NC 28625 PHONE: Business 873-4880 Home

LOCATION 21 N. TR Dunlap Gate Rd. ON Right @ jct w/ Lonesome Dove Lane

SUBDIVISION BLOCK / SECTION LOT LOT AREA 208 x 208 SITE CLASS. PS DESIGN FLOW 360 gpd L.T.A.R. 3

Septic Tank: 1000 Gallons; STB [redacted]794 Date 4-24-00

Pump Tank: Gallons; PT Date

Pump Make: Model Serial No.

Nitrification Field: No Fields 1 Square Feet 1200 Linear Feet 400

No Lines 5 Trench Width 36" Max Trench Bottom Depth 36" Gravel Depth 12"

~~New System~~ ☐ Repair System Type: I. II. III. IV. V. VI

System Description: Gravity Conventional

Repair System Description: Same

Maintenance Agreement Required: ☐ Yes ☒ No

☒ House/Mod. Home No. Bedrooms 3

☐ Mobile Home No. Bathrooms 2

☐ Business No. Employees

☐ Other


☐ Slab ☒ Crawl Space ☐ Basement w/plumbing ☐ Basement wo/plumbing

Water Supply: ☐ Individual ☐ ~~Public~~ ☐ Community

Comments/Conditions:

Comments/Conditions INSTALLED AS SHOWN WITH POLYKOR FILTER WITH TANK MARKER

INITIAL SITE SKETCH 208' 1" ≈ 60'

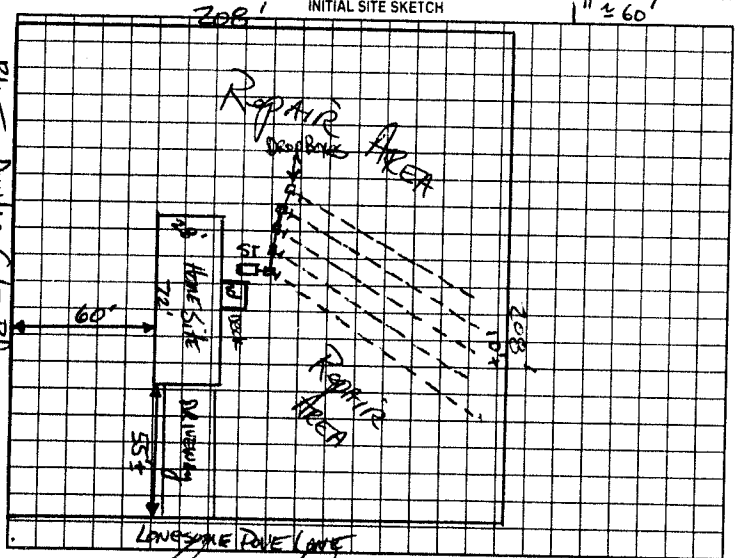

Rt. Dunlap Gate Rd

AS BUILT SKETCH

Permit can be suspended or revoked if any false information is supplied toward securing the permit/any unauthorized changes are made to the site/any unauthorized changes are made in the installation of the system. Improvement Permit with plat valid without expiration. Improvement Permit with site plan valid for sixty months. Authorization to Construct is valid for a period equal to that of Improvement Permit – not to exceed sixty months.

Signed: Larry Gruder

Improvement Permit by: RS date 8-15-00

Authorization to Construct by: RS date 8-15-00

Installed by: Tommy Fryar 3-7-2001

Operation Permit by: RSI date 3-7-2001

Existing System Inspection by: date

HEALTH DEPT. COPY: WHITE OWNER COPY (FINAL): YELLOW OWNER COPY (INITIAL): PINK