IREDELL COUNTY HEALTH DEPARTMENT

STATESVILLE 704-878-5305 MOORESVILLE 704-664-5281

IMPROVEMENT PERMIT / AUTHORIZATION TO CONSTRUCT / OPERATION PERMIT / EXISTING SYSTEM INSPECTION

PERMIT# 72742 PIN# 4767 25 7291 DATE 5-1-98

OWNER OR CONTRACTOR Acorn Development PHONE: Business 878 0072 Home

ADDRESS PO Box 5671 Statesville

LOCATION 138 Farmview LN

SUBDIVISION Farmview BLOCK / SECTION LOT 14 LOT AREA .52 acres SITE CLASS. PS DESIGN FLOW 360 L.T.A.R. .3

Septic Tank: 1000 Gallons; STB 825 Date 9-17-98
Pump Tank: Gallons; PT Date
Pump Make: Model Serial No.
Nitrification Field: No Fields 1 Square Feet 900 Linear Feet 300
No Lines 6 Trench Width 36" Max Trench Bottom Depth 36" Gravel Depth N/A

☑ New System ☐ Repair System Type: I, II, III, IV, V, VI
System Description: Gravity Chambers or HPS
Repair System Description: Pump To " "
Maintenance Agreement Required: ☐ Yes ☐ No

☑ House/Mod. Home No. Bedrooms 3
☐ Mobile Home No. Bathrooms 2
☐ Business No. Employees
☐ Other


☐ Slab ☑ Crawl Space ☐ Basement w/plumbing ☐ Basement wo/plumbing

Water Supply: ☐ Individual ☑ Public ☐ Community

Comments:/Conditions:

Drop boxes

INITIAL SITE SKETCH

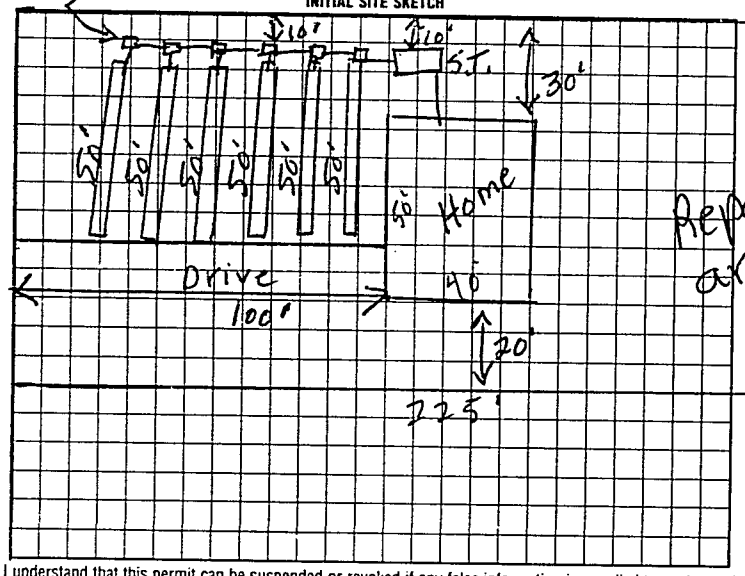

Repair area

100'

AS BUILT SKETCH

Same as initial Sketch

I understand that this permit can be suspended or revoked if any false information is supplied toward securing the permit/any unauthorized changes are made to the site/any unauthorized changes are made in the installation of the system. Improvement Permit with plat valid without expiration. Improvement Permit with site plan valid for sixty months. Authorization to Construct is valid for a period equal to that of Improvement Permit – not to exceed sixty months.

Signed: [signature] date 5-7-98 Installed by: C+W Grading

Improvement Permit by: L. C. Moore date 5-1-98 Operation Permit by: L. C. Moore date 11-19-98

Authorization to Construct by: L. C. Moore date 5-1-98 Existing System Inspection by: date

HEALTH DEPT COPY (WHITE) INSPECTION COPY (PINK) OWNER COPY (PINK) YELLOW INSPECTION COPY (PINK) OWNER COPY (PINK) GOLD

00342O