IREDELL COUNTY HEALTH DEPARTMENT

STATESVILLE 704-878-5305 MOORESVILLE 704-664-5281

IMPROVEMENT PERMIT / CERTIFICATE OF COMPLETION / OPERATION PERMIT / EXISTING SYSTEM INSPECTION

PROPERTY DESCRIPTION NO. 68876 DATE 9-2-97 TAX MAP NO. 4767 25 8401 Watershed: ☐ Yes ☐ No

OWNER OR CONTRACTOR Acorn Builders PHONE: Business 7048720072 Home

ADDRESS Po Box 5671 Statesville

LOCATION 21N TIP Dunlap Gate TR Farmview Lane 6th court

SUBDIVISION Farmview BLOCK / SECTION 1 LOT 16 LOT AREA 1.50 acres SITE CLASS PS DESIGN FLOW 360 L.T.A.R. 13

Septic Tank: 1000 Gallons; STB 1012 Date 4-17-98

Pump Tank: _____ Gallons; PT _____ Date _____

Pump Make: _____ Model _____ Serial No. _____

Nitrification Field: No Fields ___ Square Feet _____ Linear Feet _____

No Lines _____ Trench Width _____ Max Trench Bottom Depth _____ Gravel Depth _____

☑ New System ☐ Repair System Type: I, II, III, IV, V, VI

System Description: Gravity/Chambers

Repair System Description: Pump To Chambers

Maintenance Agreement Required: ☐ Yes ☑ No

☑ House/Mod. Home No. Bedrooms 3

☐ Mobile Home No. Bathrooms 2

☐ Business No. Employees ___

☐ Other _____


☐ Slab ☑ Crawl Space ☐ Basement w/plumbing ☐ Basement wo/plumbing

Water Supply: ☐ Individual ☐ Community ☑ Public


Comments:

Comments:

INITIAL SITE SKETCH

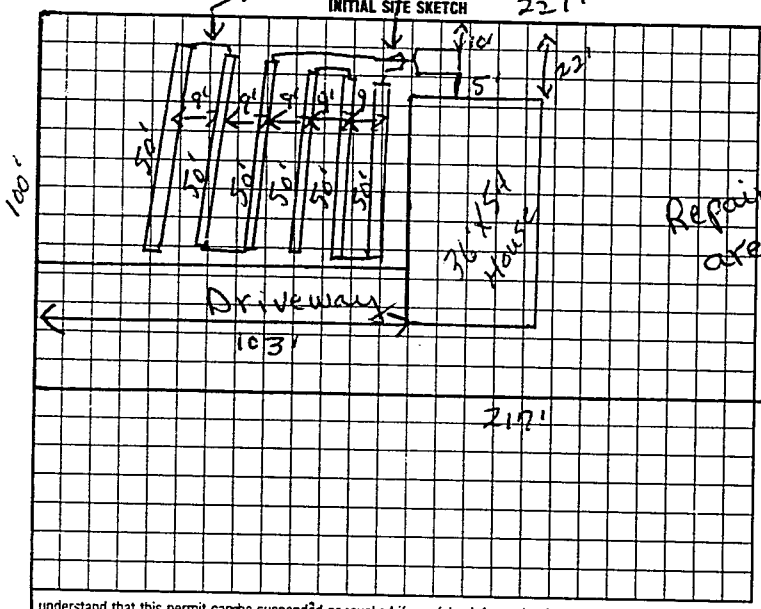

AS BUILT SKETCH

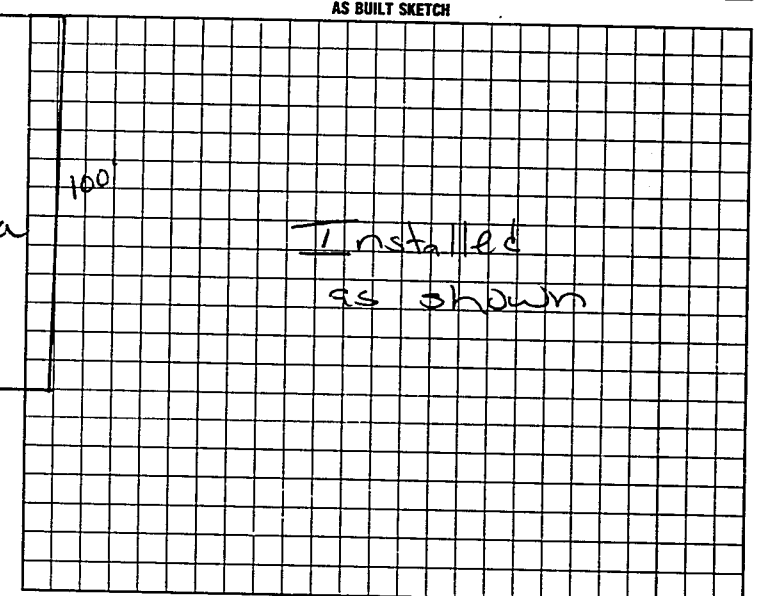

I understand that this permit can be suspended or revoked if any false information is supplied toward securing the permit/any unauthorized changes are made to the site/any unauthorized changes are made in the installation of the system. Improvement Permit is valid for 60 months from date of issuance.

Signed: Thomas H. Smith

Improvement Permit by: R. C. Moore date 9-2-97

Authorization to Construct by: R. C. Moore date 9-2-97

Authorization to count

HEALTH DEPT COPY WHITE INSPECTION COPY (FINAL) GREEN OWNER COPY (FINAL) YELLOW

Installed by: A-1 Backhoe

Certificate of Completion by: _____ date _____

Operation Permit by J. Mat C Jr RS date 6-11-98

INSPECTION COPY (INITIAL) PINK OWNER COPY (INITIAL) GOLD

Authorization to count Expires 60 months from issue

00312S