IREDELL COUNTY HEALTH DEPARTMENT

STATESVILLE 704-878-5305 MOORESVILLE 704-664-5281

IMPROVEMENT PERMIT / AUTHORIZATION TO CONSTRUCT / OPERATION PERMIT / EXISTING SYSTEM INSPECTION

PERMIT# 76750 PIN# 4746 25 8612 DATE 10-31-98

OWNER OR CONTRACTOR Acorn Dev. Inc. PHONE: Business 872-0072 Home

ADDRESS PO Box 5671 Statesville N.C.

LOCATION 21N TR Dunlap Gate Rd TR Farmview on 4th lot Rt

SUBDIVISION Farmview BLOCK / SECTION LOT 18 LOT AREA 130' X 210 SITE CLASS PS DESIGN FLOW 360 L.T.A.R. .25

Septic Tank: 1000 Gallons, STB 794 Date 4-5-00
Pump Tank: Gallons, PT Date
Pump Make: Model Serial No
Nitrification Field: No Fields 1 Square Feet 1080 Linear Feet 360
No Lines 5 Trench Width 36" Max Trench Bottom Depth 36" Gravel Depth N/A

✓ New System Repair System Type: I, II, III, IV, V, VI
System Description: Gravity 25% Red
Repair System Description: Pump To 25% Red
Maintenance Agreement Required Yes No


✓ House/Mod Home No. Bedrooms 3
Mobile Home No. Bathrooms 2
Business No. Employees
Other
Slab ✓ Crawl Space Basement w/plumbing Basement w/o plumbing

Water Supply: ☐ Individual ✓ Public ☐ Community


Comments/Conditions:

Comments/Conditions: SEPTIC TANK W/ RISERS INSTALLED USWC ~~[illegible]~~ "ZABEL" FILTER

INITIAL SITE SKETCH

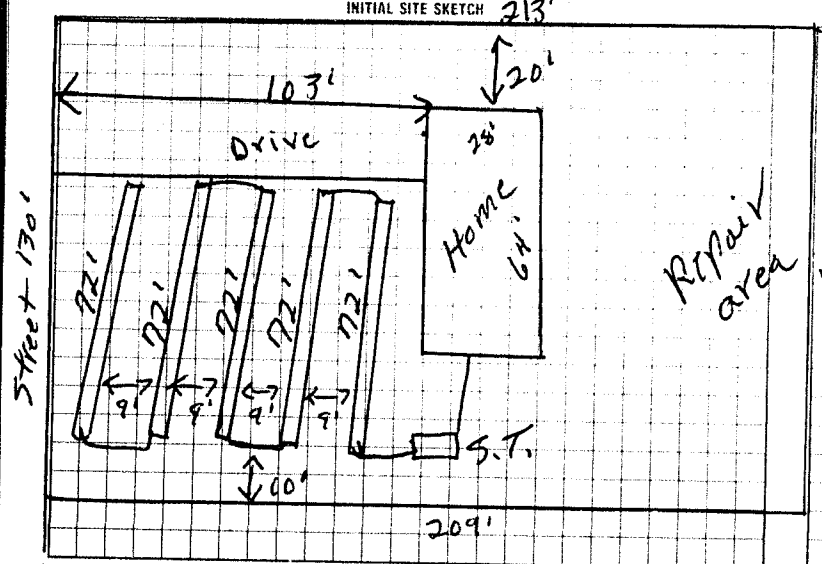

AS BUILT SKETCH

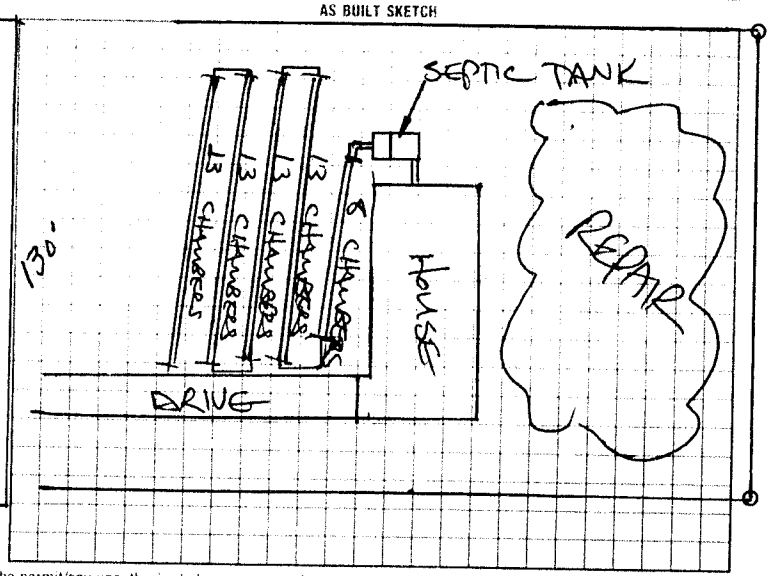

I understand that this permit can be suspended or revoked if any false information is supplied toward securing the permit/any unauthorized changes are made to the site/any unauthorized changes are made in the installation of the system. Improvement Permit with plat valid without expiration. Improvement Permit with site plan valid for sixty months. Authorization to Construct is valid for a period equal to that of Improvement Permit – not to exceed sixty months.

Signed: Thomas White date 11-2-98 Installed by: CRAIG THOMPSON

Improvement Permit by: F.C. Moore date 10-31-98 Operation Permit by: STEVE HENDRICK date 5-23-00

Authorization to Construct by: F.C. Moore date 10-31-98 Existing System Inspection by: date

HEALTH DEPT. COPY: WHITE INSPECTION COPY (FINAL) GREEN OWNER COPY (FINAL) YELLOW INSPECTION COPY (INITIAL) PINK OWNER COPY (INITIAL) GOLD