IREDELL COUNTY HEALTH DEPARTMENT

STATESVILLE 704-878-5305 MOORESVILLE 704-664-5281

IMPROVEMENT PERMIT / CERTIFICATE OF COMPLETION / OPERATION PERMIT / EXISTING SYSTEM INSPECTION

PROPERTY DESCRIPTION NO. 066104 DATE 5-22-97 TAX MAP NO. 4767258933 Watershed: ☐ Yes ☒ No

OWNER OR CONTRACTOR Acovia Development PHONE: Business 872-0003 Home

ADDRESS PO Box 5671

LOCATION Hwy 21 N TR Dunlap Gate Rd TR Farmview 1st lot Rt.

SUBDIVISION Farmview BLOCK / SECTION LOT 21 LOT AREA 100'X200' SITE CLASS PS DESIGN FLOW 360 L.T.A.R. .3

Septic Tank: 1000 Gallons; STB 1012 Date 9-21-97
Pump Tank: Gallons; PT Date
Pump Make: Model Serial No.
Nitrification Field: No Fields 1 Square Feet 900 Linear Feet 300
No Lines 4 Trench Width 36" Max Trench Bottom Depth 36" Gravel Depth N/A

☒ New System ☐ Repair System Type: I, II, III, IV, V, VI
System Description: Gravity Chambers
Repair System Description: Pump to "
Maintenance Agreement Required: ☐ Yes ☒ No

☒ House/Mod. Home No. Bedrooms 3
☐ Mobile Home No. Bathrooms 2
☐ Business No. Employees
☐ Other
☐ Slab ☒ Crawl Space ☐ Basement w/plumbing ☐ Basement wo/plumbing


Water Supply: ☐ Individual ☐ Community ☒ Public

Comments:


Comments:

* Note Upper 3 lines shortened to stay 10ft from Line + out of drainage way

INITIAL SITE SKETCH

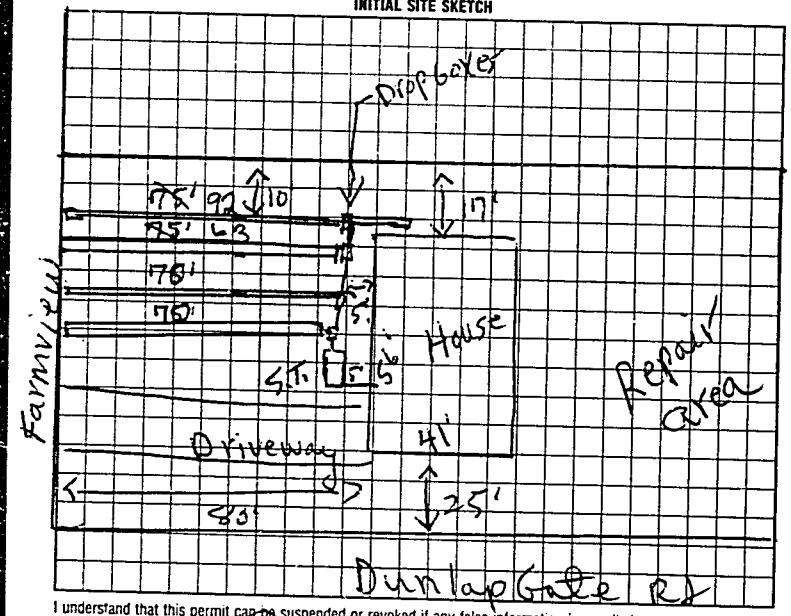

AS BUILT SKETCH

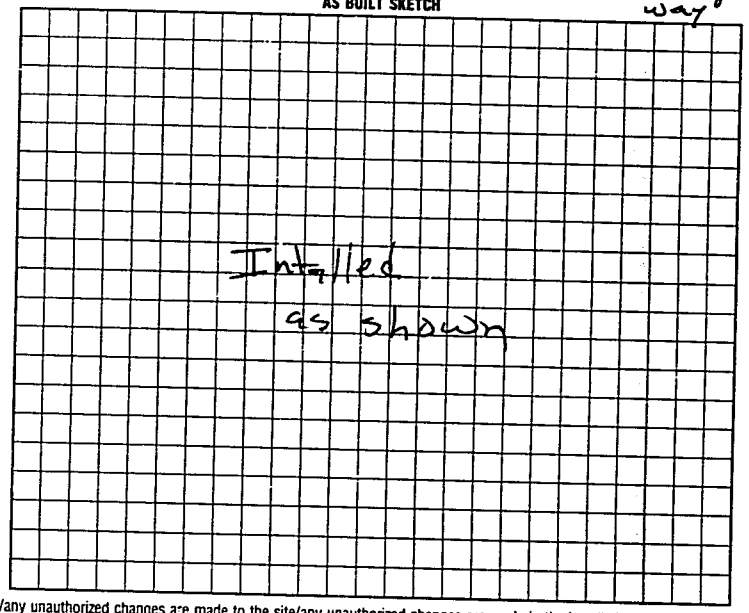

I understand that this permit can be suspended or revoked if any false information is supplied toward securing the permit/any unauthorized changes are made to the site/any unauthorized changes are made in the installation of the system. Improvement Permit is valid for 60 months from date of issuance.

Signed: Tammy White

Improvement Permit by: L.C. Moore date 5-22-97

Authorization to Install by: L.C. Moore date 5-22-97

Existing System Inspection by: HEALTH DEPT COPY WHITE INSPECTION COPY (FINAL) GREEN OWNER COPY (FINAL) YELLOW

to Count. Authorization to Count. EXPIRES 60 DAYS FROM ISSUE

Installed by: A-1 Backhoe

Certificate of Completion by: date

Operation Permit by Mary C Ott RS date 1-5-98

INSPECTION COPY (INITIAL) PINK OWNER COPY (INITIAL) GOLD