IREDELL COUNTY HEALTH DEPARTMENT

STATESVILLE 704-878-5305 MOORESVILLE 704-664-5281

IMPROVEMENT PERMIT / AUTHORIZATION TO CONSTRUCT / OPERATION PERMIT / EXISTING SYSTEM INSPECTION

PERMIT# 76747 PIN# 4746350256 DATE 10-31-98

OWNER OR CONTRACTOR Acorn Development PHONE: Business 872-0072 Home

ADDRESS PO BOX 5671

LOCATION 21 N TR Dunlap Gate Rd TR Farmview Jn 7th lot left

SUBDIVISION Farmview BLOCK / SECTION LOT 7 LOT AREA 100'X190' SITE CLASS PS DESIGN FLOW 360 L.T.A.R. .3

Septic Tank: 1000 Gallons; STB 625 Date 4-11-99
Pump Tank: Gallons; PT Date
Pump Make: Model Serial No.
Nitrification Field: No Fields 1 Square Feet 900 Linear Feet 300
No Lines 4 Trench Width 36" Max Trench Bottom Depth 36" Gravel Depth N/A

✓ New System Repair System Type: I. II. III. IV. V. VI
System Description: Gravity 625 Rock
Repair System Description: 1,250 of Rock Repair
Maintenance Agreement Required: Yes ✓ No

✓ House/Mod. Home No. Bedrooms 3
Mobile Home No. Bathrooms 2
Business No. Employees
Other


Slab ✓ Crawl Space Basement w/plumbing Basement w/o plumbing

Water Supply: ☐ Individual ✓ Public ☐ Community


Comments/Conditions:

Comments/Conditions:

INITIAL SITE SKETCH

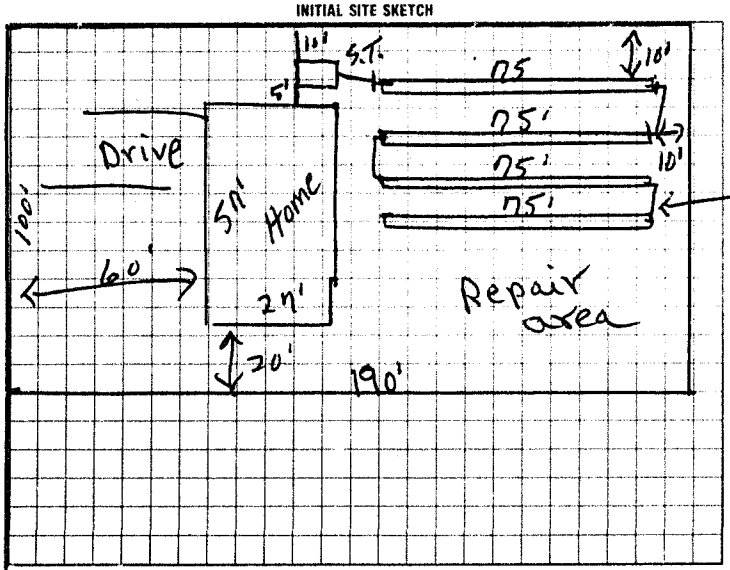

AS BUILT SKETCH

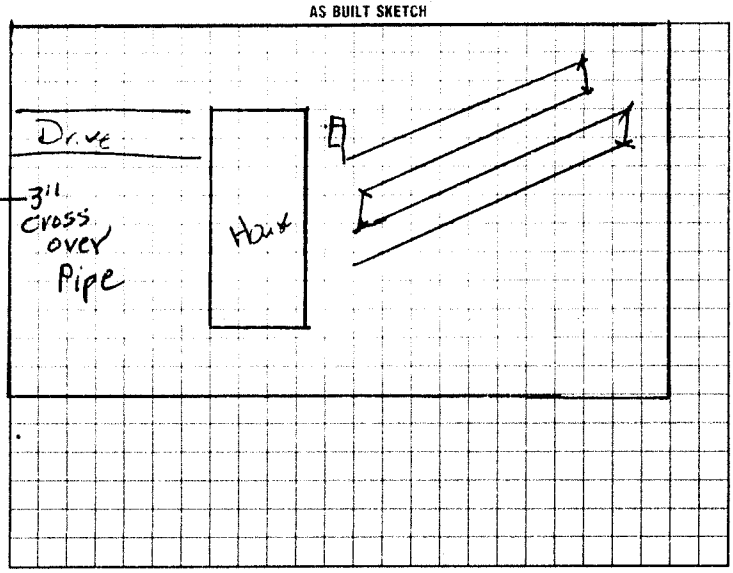

I understand that this permit can be suspended or revoked if any false information is supplied toward securing the permit/any unauthorized changes are made to the site/any unauthorized changes are made in the installation of the system. Improvement Permit with plat valid without expiration. Improvement Permit with site plan valid for sixty months. Authorization to Construct is valid for a period equal to that of Improvement Permit – not to exceed sixty months.

Signed: Thomas J White date 1-2-98 Installed by: Upright

Improvement Permit by: F. C. Moore date 10-31-98 Operation Permit by: Mac Coats RS date 6-2-99

Authorization to Construct by: F. C. Moore date 10-31-98 Existing System Inspection by: date

HEALTH DEPT. COPY: WHITE INSPECTION COPY (FINAL): GREEN OWNER COPY (FINAL) YELLOW INSPECTION COPY (INITIAL) PINK OWNER COPY (INITIAL): GOLD