IREDELL COUNTY HEALTH DEPARTMENT

STATESVILLE 704-878-5305 MOORESVILLE 704-664-5281

IMPROVEMENT PERMIT / CERTIFICATE OF COMPLETION / OPERATION PERMIT / EXISTING SYSTEM INSPECTION

PROPERTY DESCRIPTION NO. 68868 DATE 9-2-97 TAX MAP NO. 4767350366 Watershed: ☐ Yes ☐ No

OWNER OR CONTRACTOR Acorn Builders PHONE: Business 704872-0022 Home

ADDRESS PO Box 5671 Statesville

LOCATION US 21 N TR Dunlap Gate Rd TR Farmview Ln 6th lot left

SUBDIVISION Farmview BLOCK / SECTION LOT 6 LOT AREA .44 acres SITE CLASS. PS DESIGN FLOW 360 L.T.A.R. .28

Septic Tank: 1000 Gallons; STB 1012 Date 4-17-98

Pump Tank: Gallons; PT Date

Pump Make: Model Serial No.

Nitrification Field: No Fields 1 Square Feet 1260 Linear Feet 420

No Lines 6 Trench Width 36" Max Trench Bottom Depth 36" Gravel Depth 12"

☒ New System ☐ Repair System Type: I, II, III, IV, V, VI

System Description: Conv. Gravity

Repair System Description: Pump To Chambers

Maintenance Agreement Required: ☐ Yes ☒ No

☒ House/Mod. Home No. Bedrooms 3

☐ Mobile Home No. Bathrooms 2

☐ Business No. Employees

☐ Other

☐ Slab ☒ Crawl Space ☐ Basement w/plumbing ☐ Basement wo/plumbing


Water Supply: ☐ Individual ☐ Community ☒ Public

Comments:


Comments:

* Tank located opposite side of House

INITIAL SITE SKETCH

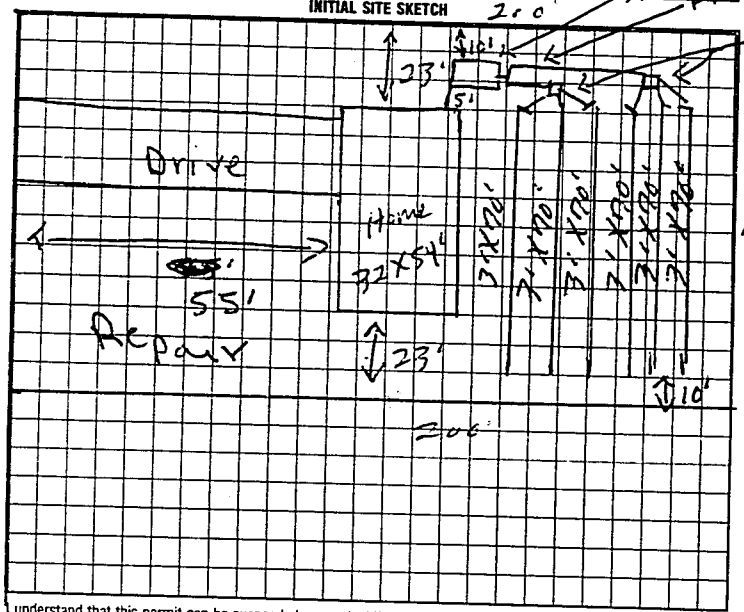

AS BUILT SKETCH

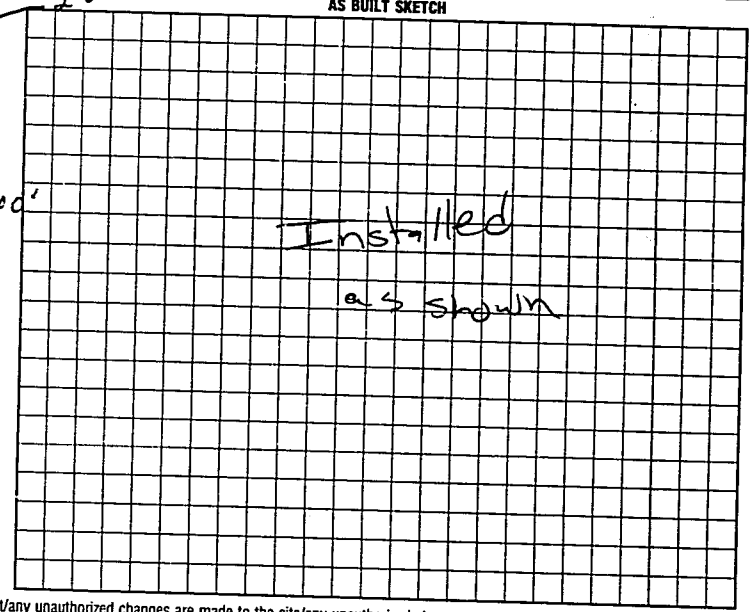

I understand that this permit can be suspended or revoked if any false information is supplied toward securing the permit/any unauthorized changes are made to the site/any unauthorized changes are made in the installation of the system. Improvement Permit is valid for 60 months from date of issuance.

Signed: Homer J. White

Improvement Permit by: P. C. Moore date 9-2-97

Existing System Inspection by: P. C. Moore date 9-2-97

Installed by: A-1 Backhoe

Certificate of Completion by: date

Operation Permit by: date 6-11-98

HEALTH DEPT COPY WHITE INSPECTION COPY (FINAL) GREEN OWNER COPY (FINAL) YELLOW INSPECTION COPY (INITIAL) PINK OWNER COPY (INITIAL) GOLD

* Authorization to Count Expires 60 mos from issue