IREDELL COUNTY HEALTH DEPARTMENT

STATESVILLE 704-878-5305 MOORESVILLE 704-664-5281

~~1100~~ 49067

IMPROVEMENT PERMIT / CERTIFICATE OF COMPLETION / OPERATION PERMIT / EXISTING SYSTEM INSPECTION

PROPERTY DESCRIPTION NO. 17132 DATE 10-12-93 TAX MAP NO. 11M-1-4-0

OWNER OR CONTRACTOR Acorn Development Co. PHONE: Business Home 872-0072 Watershed: ☐ Yes ☒ No

ADDRESS PO Box 5651 Statesville

LOCATION US 21 N TR Dunlap Gate Rd To Farmview 2nd lot on left.

SUBDIVISION Farmview BLOCK / SECTION LOT 2 LOT AREA 100 X 190 SITE CLASS. PS DESIGN FLOW 360 L.T.A.R. .3

Septic Tank: 1000 Gallons; STB 1017 Date 9-25-83

Pump Tank: Gallons; PT Date

Pump Make: Model Serial No.

Nitrification Field: No Fields 1 Square Feet 1200 Linear Feet 400

No Lines 5 Trench Width 36 Max Trench Bottom Depth 36 Gravel Depth 12

☒ New System ☐ Repair System Type: I (II) III, IV, V, VI

System Description: Conv. Gravity

Repair System Description: Pumpto Porus Block Panel

Maintenance Agreement Required: ☐ Yes ☐ No

☒ House/Mod. Home No. Bedrooms 3

☐ Mobile Home No. Bathrooms 2

☐ Business No. Employees

☐ Other


☐ Slab ☒ Crawl Space ☐ Basement w/plumbing ☐ Basement wo/plumbing

Water Supply: ☐ Individual ☐ Community ☒ Public


Comments:

Comments:

INITIAL SITE SKETCH

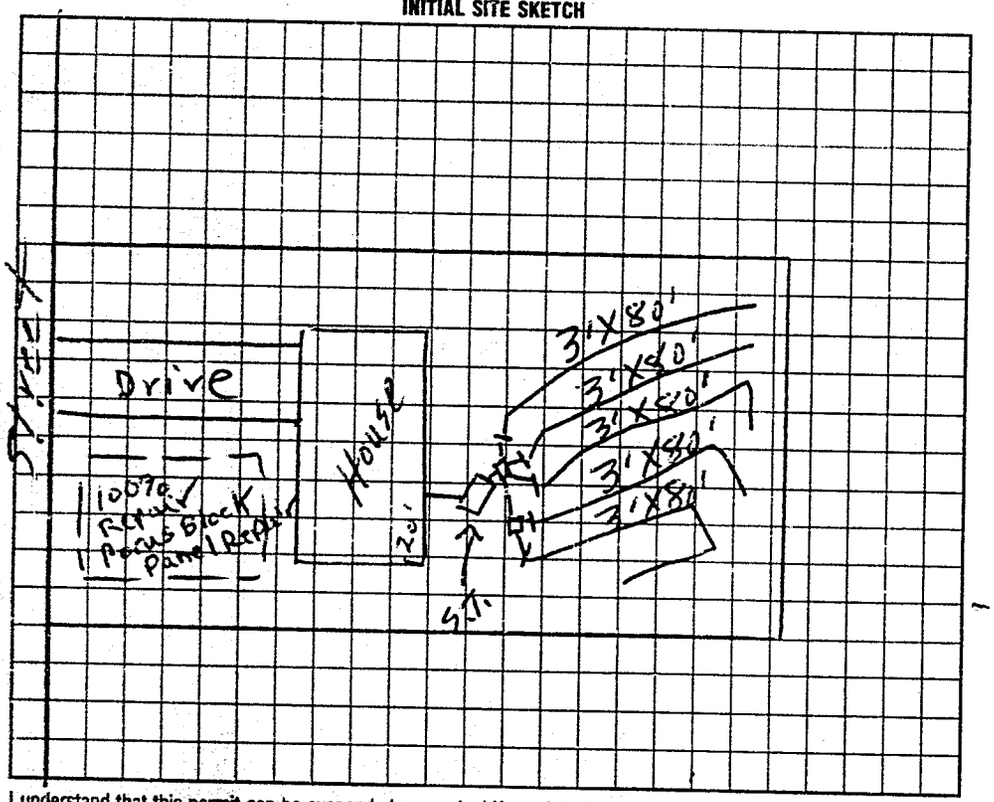

AS BUILT SKETCH

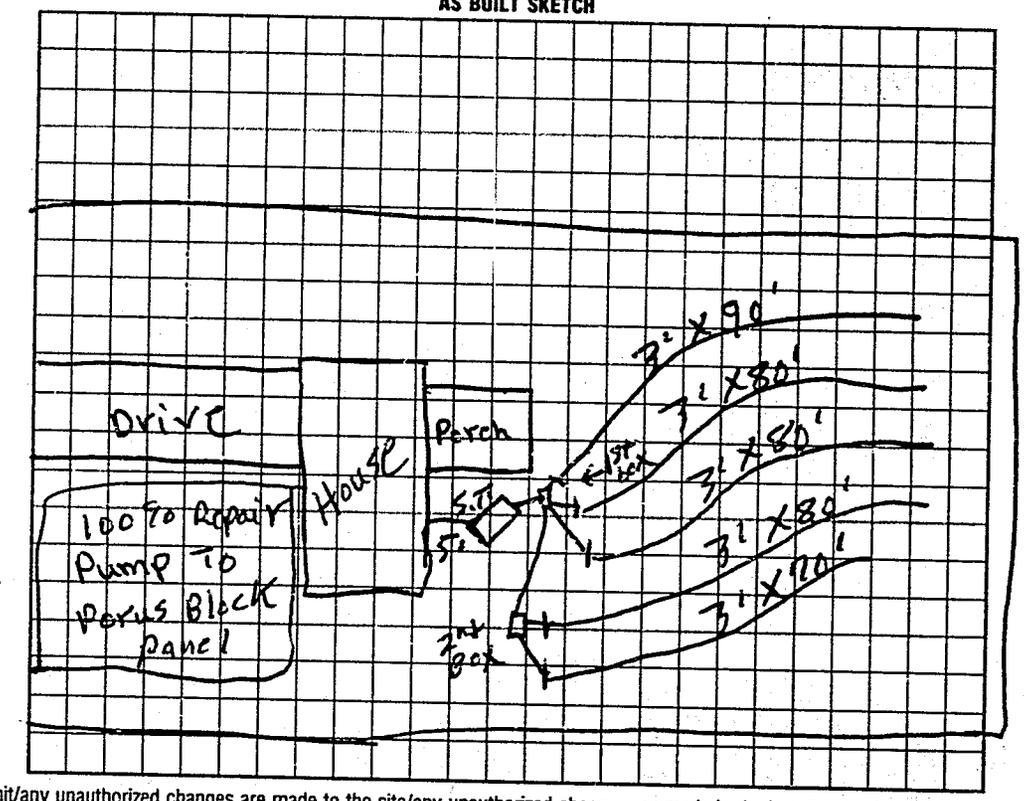

I understand that this permit can be suspended or revoked if any false information is supplied toward securing the permit/any unauthorized changes are made to the site/any unauthorized changes are made in the installation of the system. Improvement Permit is valid for 60 months from date of issuance.

Signed: Thomas J. White

Improvement Permit by: F. C. Moore date 10-12-93

Existing System Inspection by: date

Installed by: James Hutler

Certificate of Completion by: F. C. Moore date 3-7-94

Operation Permit by: date

HEALTH DEPT. COPY: WHITE INSPECTION COPY (FINAL): GREEN OWNER COPY (FINAL): YELLOW INSPECTION COPY (INITIAL): PINK OWNER COPY (INITIAL): GOLD