# IREDELL COUNTY HEALTH DEPARTMENT

STATESVILLE 704-878-5305 MOORESVILLE 704-664-5281

## IMPROVEMENT PERMIT / AUTHORIZATION TO CONSTRUCT / OPERATION PERMIT / EXISTING SYSTEM INSPECTION

PERMIT# 72744 PIN# 4767 35 6986 DATE 5-1-98

OWNER OR CONTRACTOR Acorn Development PHONE: Business 872 0072 Home

ADDRESS PO BOX 5671 Statesville, N.C.

LOCATION 103 Farmview Acres lot 1 2 1/2 N. TR Farmview 1st lot left.

SUBDIVISION Farmview Acres BLOCK / SECTION LOT 1 LOT AREA 1/2acre + SITE CLASS. PS DESIGN FLOW 360 L.T.A.R. .3

Septic Tank: 1000 Gallons; STB AA Date 4-5-00
Pump Tank: Gallons; PT Date
Pump Make: Model Serial No.
Nitrification Field: No Fields 1 Square Feet 1200 Linear Feet 400
No Lines 6 Trench Width 36" Max Trench Bottom Depth 36" Gravel Depth 12"

☑ New System ☐ Repair System Type: I, II, III, IV, V, VI
System Description: Conv. Gravity
Repair System Description: Gravity Chambers
Maintenance Agreement Required: ☐ Yes ☑ No

☑ House/Mod. Home No. Bedrooms 3
☐ Mobile Home No. Bathrooms 2
☐ Business No. Employees
☐ Other


☐ Slab ☑ Crawl Space ☐ Basement w/plumbing ☐ Basement wo/plumbing

Water Supply: ☐ Individual ☑ Public ☐ Community

Comments:/Conditions:

Comments:/Conditions: SEPTIC TANK W/ RISERS AND MARKER INSTALLED USING "ZABEL" FILTER

**INITIAL SITE SKETCH**

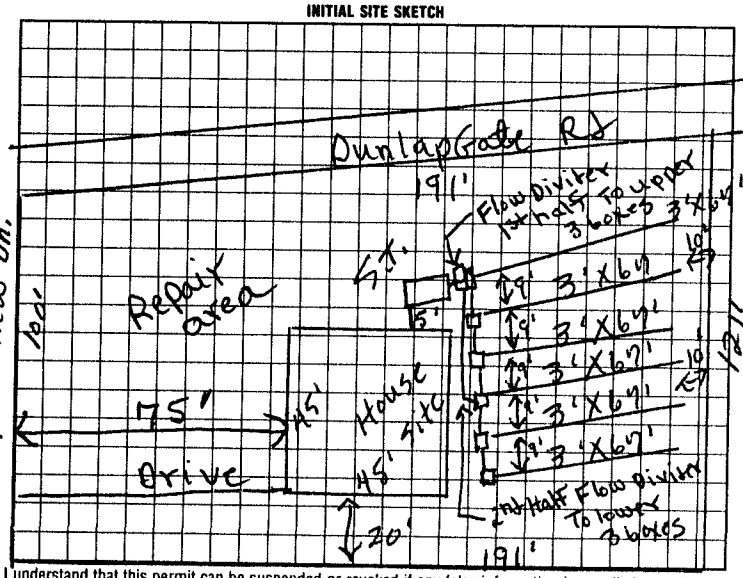


**AS BUILT SKETCH**

SYSTEM INSTALLED ACCORDING TO INITAL SITE SKETCH

I understand that this permit can be suspended or revoked if any false information is supplied toward securing the permit/any unauthorized changes are made to the site/any unauthorized changes are made in the installation of the system. Improvement Permit with plat valid without expiration. Improvement Permit with site plan valid for sixty months. Authorization to Construct is valid for a period equal to that of Improvement Permit – not to exceed sixty months.

Signed: Thomas J. White date 5-5-98

Improvement Permit by: R. C. Moore date 5-1-98

Authorization to Construct by: R. C. Moore date 5-1-98

Installed by: CRAIG THOMPSON

Operation Permit by: STEVE HEDRICK date 5-23-00

Existing System Inspection by: date

HEALTH DEPT. COPY: WHITE INSPECTION COPY (FINAL): GREEN OWNER COPY (FINAL): YELLOW INSPECTION COPY (INITIAL): PINK OWNER COPY (INITIAL): GOLD