IREDELL COUNTY HEALTH DEPARTMENT

STATESVILLE 704-878-5305 (CI) MOORESVILLE 704-664-5281

IMPROVEMENT PERMIT / AUTHORIZATION TO CONSTRUCT / OPERATION PERMIT / EXISTING SYSTEM INSPECTION

PERMIT# 106021 PIN# 4767-36-0139 DATE 03-31-03

OWNER OR CONTRACTOR EDDIE JOSEY PHONE: Business 704-902-4239 Home

ADDRESS 345 DUNLAP GATE RD STATESVILLE NC 28625

LOCATION 21 NORTH, (E) DUNLAP GATE (D) ATBOX # 345

SUBDIVISION BLOCK / SECTION LOT LOT AREA 1.5 AC SITE CLASS. PS DESIGN FLOW 240 L.T.A.R. .3

Septic Tank: 1000 Gallons; STB Date

Pump Tank: Gallons; PT Date

Pump Make: Model Serial No.

Nitrification Field: No Fields Square Feet 300' Linear Feet 266'

No Lines 2 Trench Width 3' Max Trench Bottom Depth / Gravel Depth 12"

☐ New System ☐ Repair System Type: I (II) III, IV, V, VI

System Description: GRAVELY

Repair System Description: SAME

Maintenance Agreement Required: ☐ Yes ☒ No

☐ House/Mod. Home No. Bedrooms 2

☒ Mobile Home No. Bathrooms 2

☐ Business No. Employees

☐ Other

☐ Slab ☒ Crawl Space ☐ Basement w/plumbing ☐ Basement wo/plumbing


Water Supply: ☐ Individual ☒ Public ☐ Community

Comments:/Conditions:

Comments:/Conditions: (1) NO SIGNS OF FAILURE AT TIME OF CHECK (2) TAKING OFF 2 BED ROOM, PUTTING ON 2 BEDROOM (3) MAINTAIN SETBACKS.

INITIAL SITE SKETCH

AS BUILT SKETCH

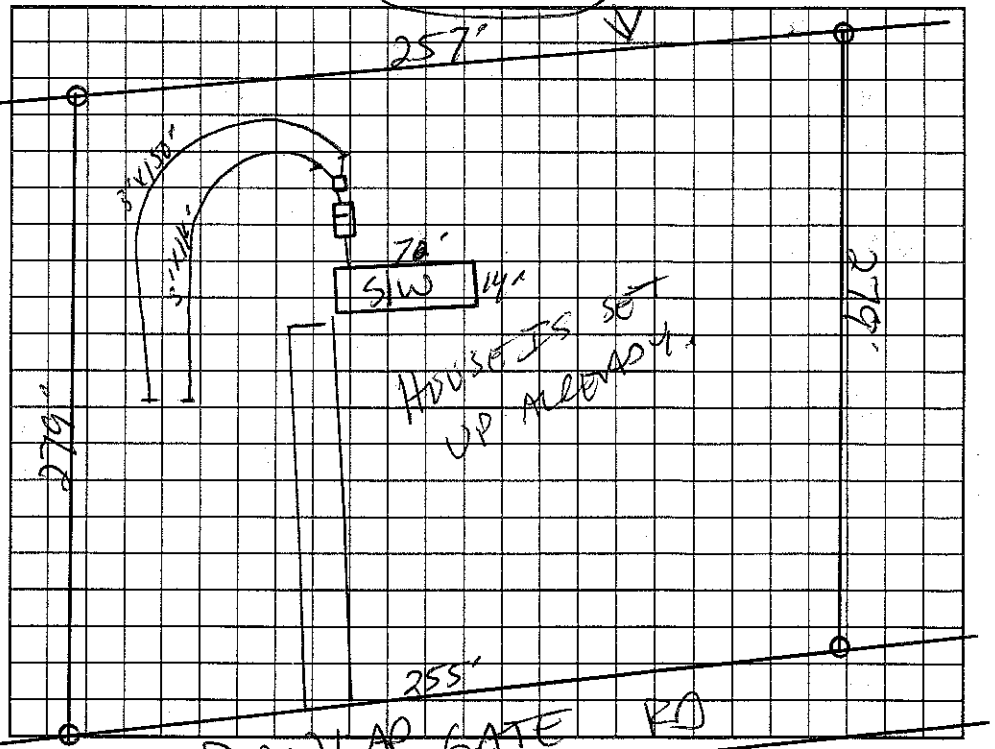

Permit can be suspended or revoked if any false information is supplied toward securing the permit/any unauthorized changes are made to the site/any unauthorized changes are made in the installation of the system. Improvement Permit with plat valid without expiration. Improvement Permit with site plan valid for sixty months. Authorization to Construct is valid for a period equal to that of Improvement Permit – not to exceed sixty months.

Signed: date 3-31-03 Installed by: A-1 Backhoe

Improvement Permit by: date Operation Permit by: date

Authorization to Construct by: date Existing System Inspection by: date

HEALTH DEPT. COPY: WHITE OWNER COPY (FINAL): YELLOW OWNER COPY (INITIAL): PINK