IREDELL COUNTY HEALTH DEPARTMENT

STATESVILLE 704-878-5305 MOORESVILLE 704-664-5281

IMPROVEMENT PERMIT / CERTIFICATE OF COMPLETION / OPERATION PERMIT / EXISTING SYSTEM INSPECTION

PROPERTY DESCRIPTION NO. 23185 DATE 2/28/96 TAX MAP NO 11-M-A-37D Watershed Yes ✓No

OWNER OR CONTRACTOR Jeffrey Holton PHONE Business Home 873-3333

ADDRESS 154 Matthew Dr. Statesville NC

LOCATION Old Mocksville Rd - TR Chestnut Grove Rd - TL Beechwood Farm Rd - 1st house on (L) - Trailer behind house.

SUBDIVISION BLOCK / SECTION LOT LOT AREA 10 ac. SITE CLASS DESIGN FLOW 360gpd LTAR Existing

Septic Tank: 1000 Gallons; STB Date

Pump Tank: Gallons; PT Date

Pump Make: Model Serial No

Nitrification Field: No Fields 1 Square Feet 750 Linear Feet 250

No Lines 2 Trench Width Max Trench Bottom Depth

New System Repair System Type: CONVENTIONAL

System Description: Gravity Conventional

Repair System Description

Maintenance Agreement Required Yes No

Gravel Depth 10" Slab ✓Crawl Space Basement w/plumbing Basement w/o plumbing

House/Mod Home No Bedrooms 3

✓Mobile Home No Bathrooms 1½

Business No Employees


Other

Water Supply: ✓Individual Community Public


Comments:

Comments: Keep Mobile Home 5ft away from any part of Septic System.

INITIAL SITE SKETCH

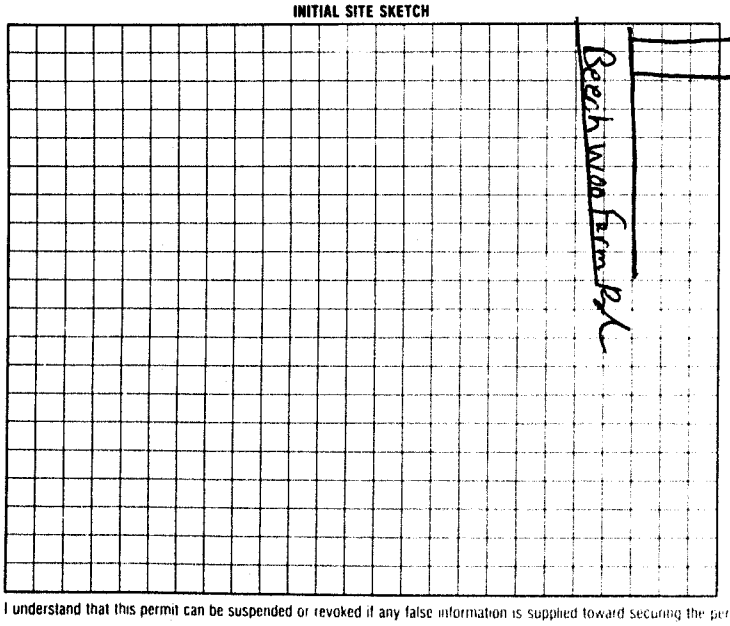

AS BUILT SKETCH

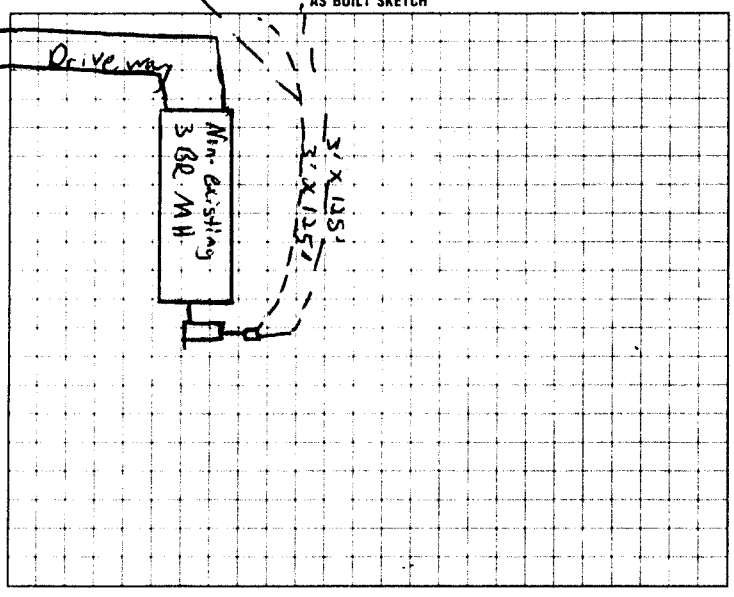

I understand that this permit can be suspended or revoked if any false information is supplied toward securing the permit; any unauthorized changes are made to the site; any unauthorized changes are made in the installation of the system

Signed

Improvement Permit by date

Existing System Inspection by C. Brady Fowler date 2/29/96

Installed by

Certificate of Completion by date

Operation Permit by date

HEALTH DEPT COPY WHITE INSPECTION COPY (FINAL) GREEN OWNER COPY (FINAL) YELLOW INSPECTION COPY (INITIAL) PINK OWNER COPY (INITIAL) GOLD