IREDELL COUNTY HEALTH DEPARTMENT

Statesville Office (704) 878-5305 Mooresville Office (704) 660-3625

IMPROVEMENT PERMIT / AUTHORIZATION TO CONSTRUCT / OPERATION PERMIT / EXISTING SYSTEM

PERMIT # 203289

APPLICANT: Trevor Carden PIN # 4767586325

SITE ADDRESS: 770 Church Lake Rd Statesville NC 28625 APPLICANT ADDRESS: 103 Green Meadows Ln Statesville NC 28625

SITE DIRECTIONS: Old Mocksville Rd to Church Lake Rd 1/2 mile on left PHONE: 704-682-3476 ALT. PHONE: N/A

SUBDIVISION: Rash Limited Partnership SECTION: N/A LOT # 1 LOT AREA: 2.577ac DESIGN FLOW: 200 L.T.A.R.: 0.3

Septic Tank	1000 (gal)	STB	760	Date	1-20-14	[X] New System	[ ] Repair	[ ] Expansion	System Type: I II [III] IV V VI
Pump Tank	N/A (gal)	PT	N/A	Date	N/A	System Description:	25% Reduction		
Pump Make	N/A	Model	Pollock	Serial #	PL-66	Repair System Description:	Pump 25% Reduction		
# Nitrification Fields	1	# Lines	14	Linear Ft:	160	Maintenance Agreement Required:	[ ] YES	[X] NO	
Trench Width	36"	Max. Trench Bottom Depth	36"	Gravel Depth	N/A	[X] GRAVITY	[ ] PRESSURE		

[ ] Residence [ ] Business [X] Other Barn [X] Slab [ ] Basement w/plumbing


No. Bedrooms 1 No. Persons Bathroom No. Employees Crawl Space

[ ] Basement w/o plumbing


Water Supply: [ ] Private [X] Public [ ] Community

Comments / Conditions: Install 25% Reduction on contour with serial distribution. Owner request larger system for Barn Bathroom

INITIAL SITE SKETCH

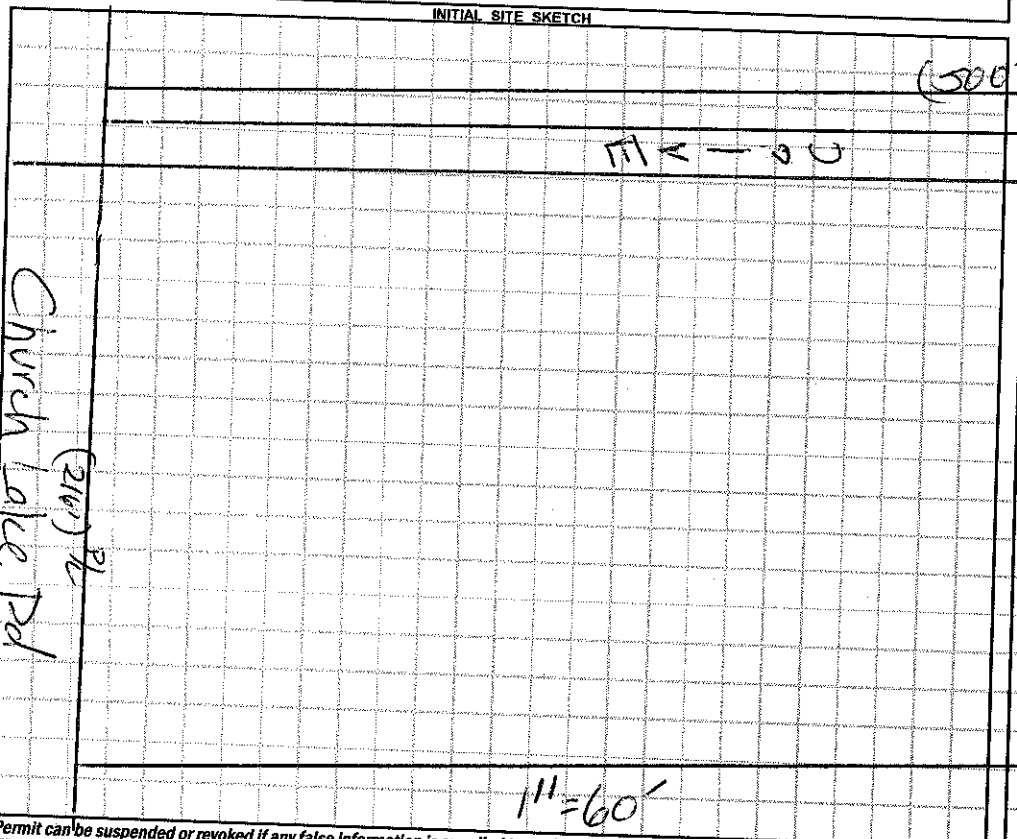

AS BUILT SKETCH

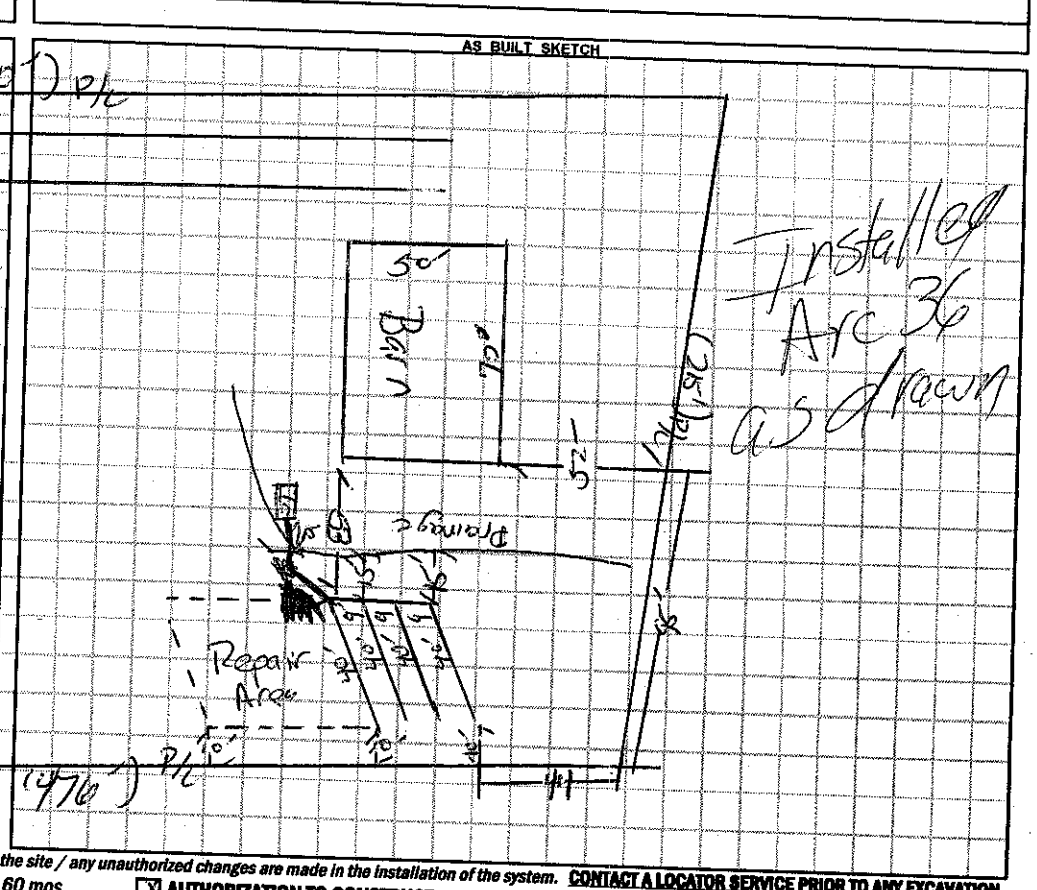

Permit can be suspended or revoked if any false information is supplied toward securing the permit / any unauthorized changes are made to the site / any unauthorized changes are made in the installation of the system. CONTACT A LOCATOR SERVICE PRIOR TO ANY EXCAVATION

[ ] IMPROVEMENT PERMIT with plat valid without expiration.

[X] IMPROVEMENT PERMIT with site plan valid for 60 mos.

[X] AUTHORIZATION TO CONSTRUCT valid for period equal to IMPROVEMENT PERMIT--not to exceed 60 mo.

Owner / Applicant Signature: Carden Date:

IMPROVEMENT PERMIT by: Robert A Lowe Date: 06/11/14

AUTHORIZATION TO CONSTRUCT by: Robert A Lowe Date: 06/23/14

Installed by: A beals & racking

OPERATION PERMIT by: Robert A Lowe Date: 11/20/14

Existing System Inspected by: Date:

Health Dept. Copy - WHITE Applicant (Final Approval) - YELLOW Applicant (Conditional Approval) - PINK