IREDELL COUNTY HEALTH DEPARTMENT

IMPROVEMENT PERMIT / AUTHORIZATION TO CONSTRUCT / OPERATION PERMIT / EXISTING SYSTEM INSPECTION

STATESVILLE 704-878-5305 MOORESVILLE 704-664-5281

PERMIT# REPAIR PIN# 4767-64-3986 DATE 4-7-08

OWNER OR APPLICANT WILLIAM C. LECKIE PHONE: Business STATESVILLE, NC 28625-1452 Home 704-872-1137

ADDRESS 1314 OLD MOCKSVILLE ROAD, IL OLD MOCKSVILLE ROAD, 2ND DRIVE ON RIGHT

LOCATION US 21 NORTH, TR DOWNAD GATE ROAD

SUBDIVISION BLOCK / SECTION LOT LOT AREA 2.1 ACRES SITE CLASS. P5 DESIGN FLOW 360 L.T.A.R. EXISTING

Septic Tank: 1000 Gallons; STB 760 Date 11-11-07

Pump Tank: Gallons; PT Date

Pump Make: Model Serial No.

Nitrification Field: No Fields 1 Square Feet — Linear Feet —

No Lines 3 Trench Width — Max Trench Bottom Depth Gravel Depth —

☐ New System ☑ Repair ☐ Expansion System Type: I (II) III IV V VI

System Description:

Repair System Description: CONVENTIONAL GRAVITY

Maintenance Agreement Required: ☐ Yes ☐ No

☐ Gravity ☐ Pressure ☐ Slab ☐ Crawl Space ☐ Basement w/plumbing ☐ Basement wo/plumbing

☑ House/Mod. Home No. Bedrooms 3

☐ Mobile Home No. Persons

☐ Business No. Employees


☐ Other

Water Supply: ☑ Individual ☐ Public ☐ Community Well

Comments:/Conditions: REPLACE EXISTING SEPTIC TANK AS SHALLOW AS POSSIBLE, USING RISERS AS NEEDED.

Comments:/Conditions: SYSTEM REPAIRED AS SHOWN WITH NEW SEPTIC TANK WITH RISERS.

INITIAL SITE SKETCH

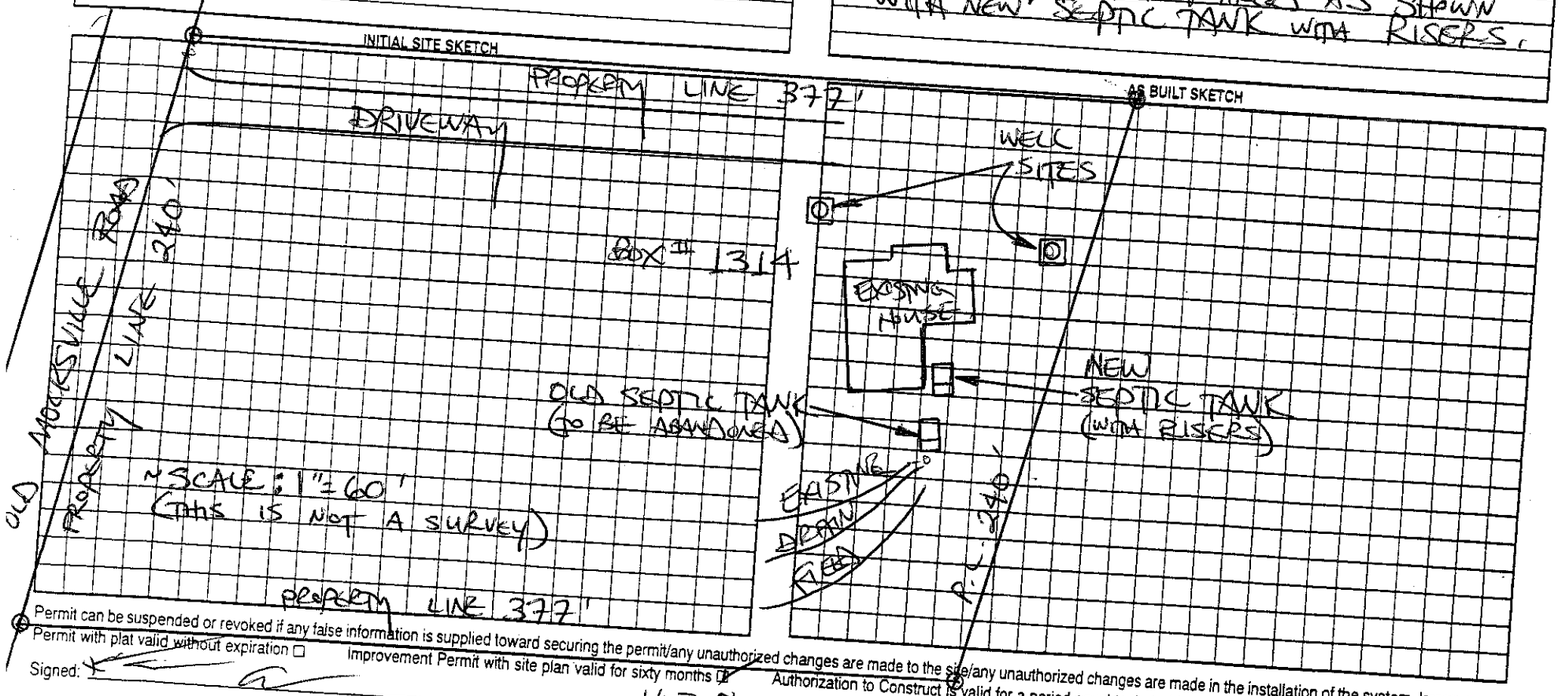

AS BUILT SKETCH

Permit can be suspended or revoked if any false information is supplied toward securing the permit/any unauthorized changes are made to the site/any unauthorized changes are made in the installation of the system. Improvement Authorization to Construct is valid for a period equal to that of Improvement Permit – not to exceed sixty months.

Permit with plat valid without expiration ☐ Improvement Permit with site plan valid for sixty months ☑

Signed: K

Improvement Permit by: STEVE HENDRICK date 4-7-8

Authorization to Construct by: STEVE HENDRICK date 4-7-08

Installed by: TIM ABEE

Operation Permit by: STEVE HENDRICK date 4-8-08

Existing System Inspection by: date

HEALTH DEPT. COPY: WHITE OWNER COPY (FINAL): YELLOW OWNER COPY (INITIAL): PINK