IREDELL COUNTY HEALTH DEPARTMENT

STATESVILLE 704-878-5305 CI   MOORESVILLE 704-664-5281

IMPROVEMENT PERMIT / AUTHORIZATION TO CONSTRUCT / OPERATION PERMIT / EXISTING SYSTEM INSPECTION

PERMIT# 092007   PIN# ~~4767666287~~ 4767-65-0954   DATE 4-19-01

OWNER OR CONTRACTOR ALAN LEWIS   PHONE: Business ______   Home 704-878-2305

ADDRESS 118 NEW HOPE RD, STATESVILLE, NC 28625

LOCATION OLDS MOCK RD, (L) CHURCH LAKE, (R) STONE CREEK ON CORNER

SUBDIVISION STONECREEK   BLOCK / SECTION ______   LOT 2   LOT AREA .75   SITE CLASS. PS   DESIGN FLOW 360   L.T.A.R. .3

Septic Tank: 1000 Gallons; STB TOTZ Date 5-17-03
Pump Tank: ______ Gallons; PT ______ Date ______
Pump Make: ______ Model ______ Serial No. ______
Nitrification Field: No Fields 1 Square Feet 1200 Linear Feet 400
No Lines 5 Trench Width 36" Max Trench Bottom Depth 36" Gravel Depth 12"

☒ New System ☐ Repair System Type: I (II) III, IV, V, VI
System Description: CONV GRAV
Repair System Description: PUMP CONV
Maintenance Agreement Required: ☐ Yes ☒ No


☒ House/Mod. Home   No. Bedrooms 3
☐ Mobile Home   No. Bathrooms 2
☐ Business   No. Employees ______
☐ Other ______
☐ Slab ☒ Crawl Space ☐ Basement w/plumbing ☐ Basement wo/plumbing

Water Supply:
☐ Individual
☒ Public
☐ Community


Comments:/Conditions: (1) INSTALL LINES ON CONTOUR & SPLIT FEED (2) Use Drop Boxes (3) KEEP SYSTEM 5' off house & 10' off property line (4) COMPLEX CONTOURS ON SIDESLOPE, BE CAREFUL

Comments:/Conditions: Tuff-Tite filter & ST marker
108 ft from House to PL @ Church Lake Road

INITIAL SITE SKETCH 1"=50'

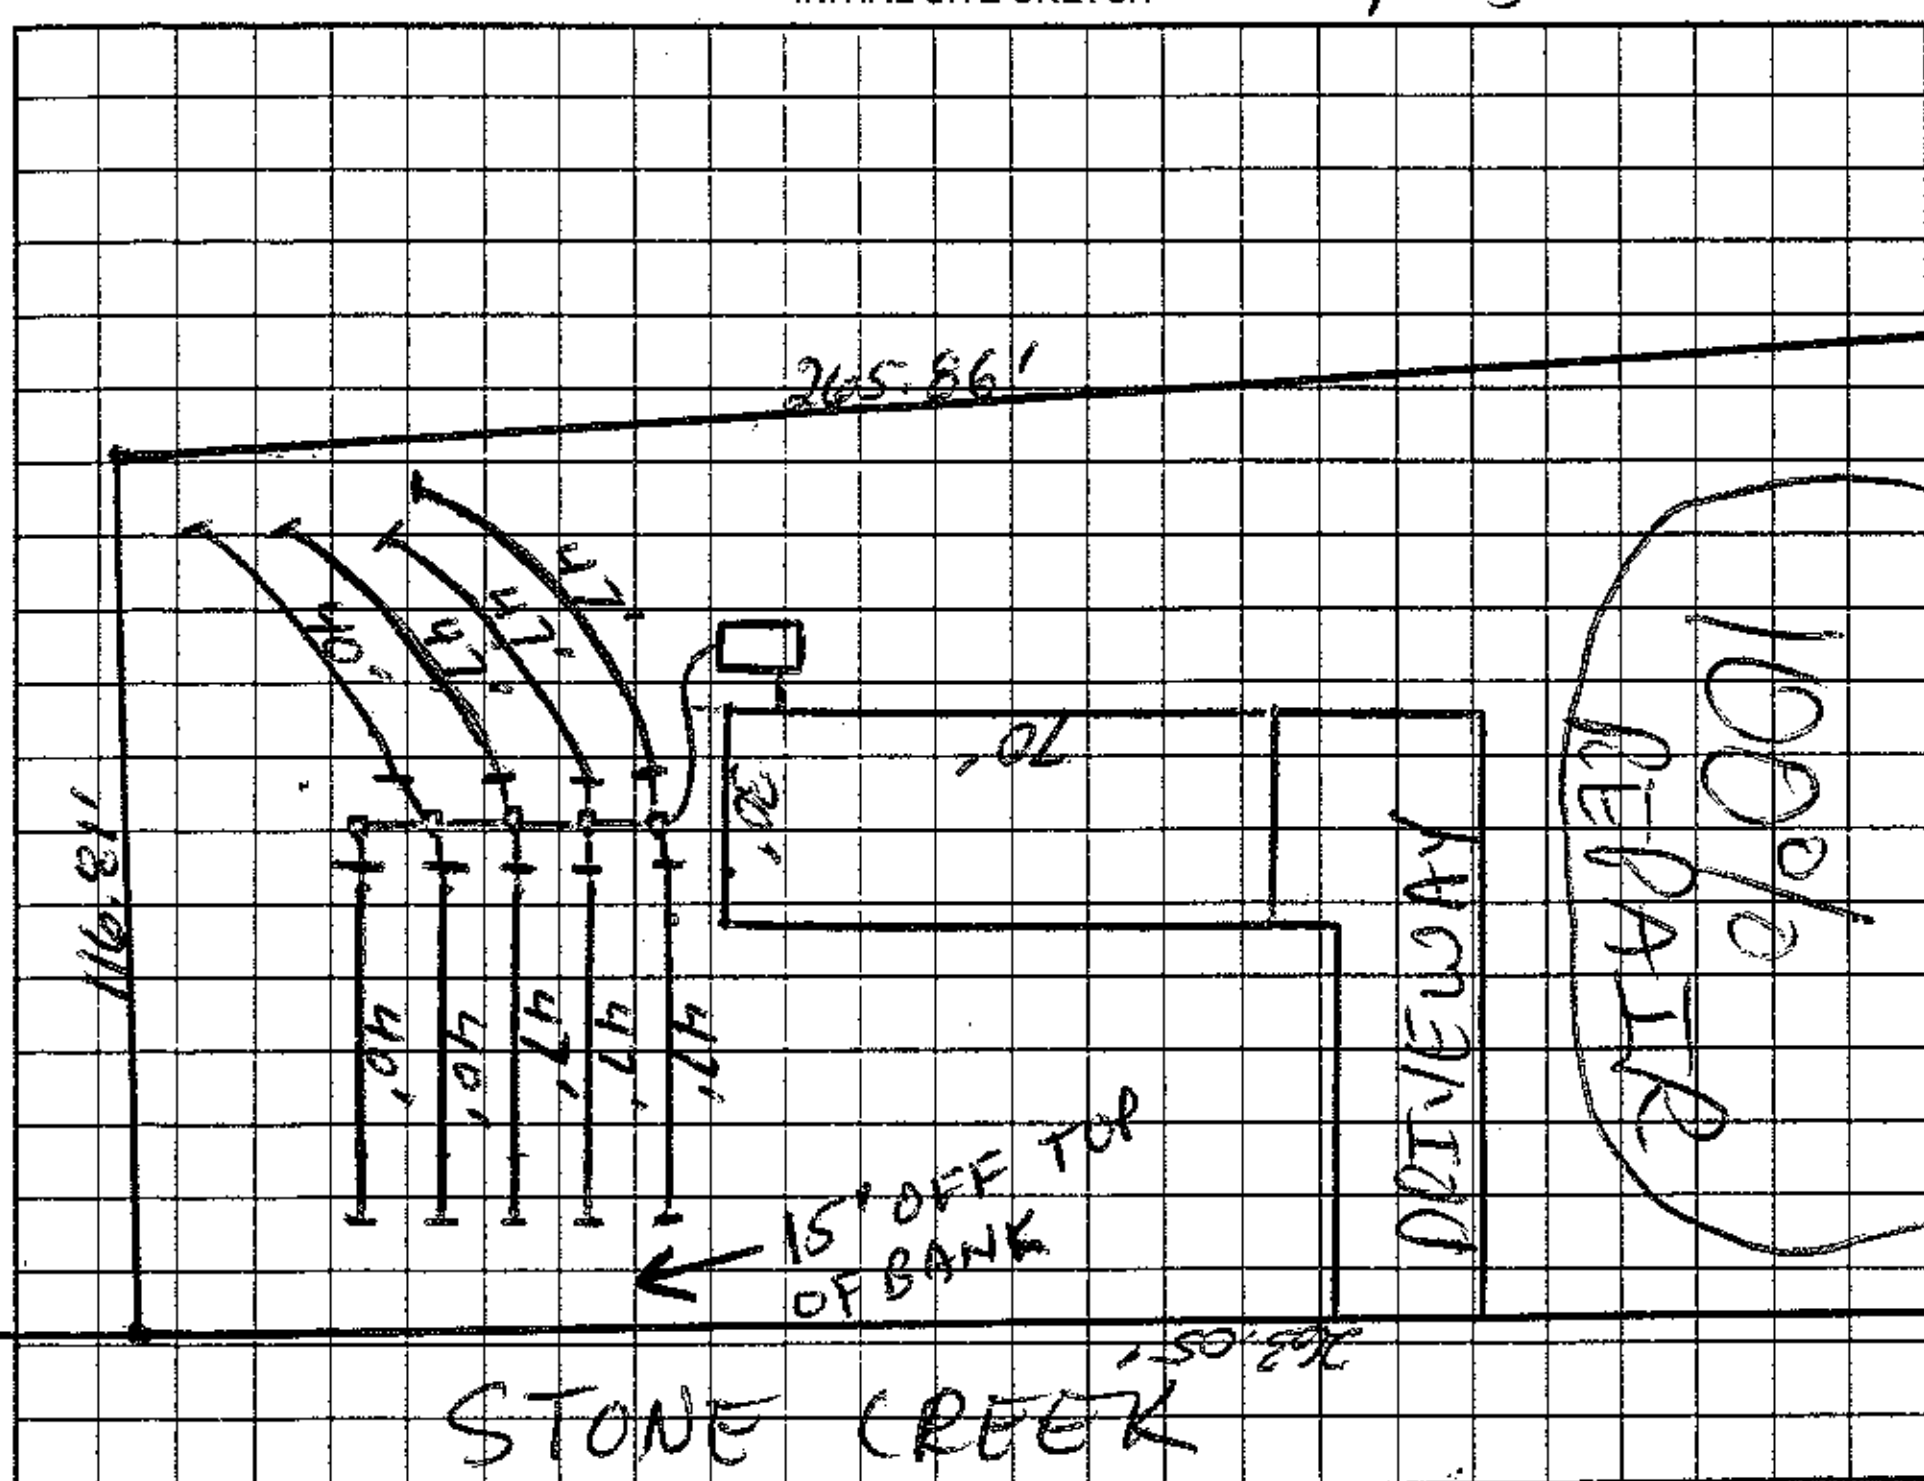

AS BUILT SKETCH

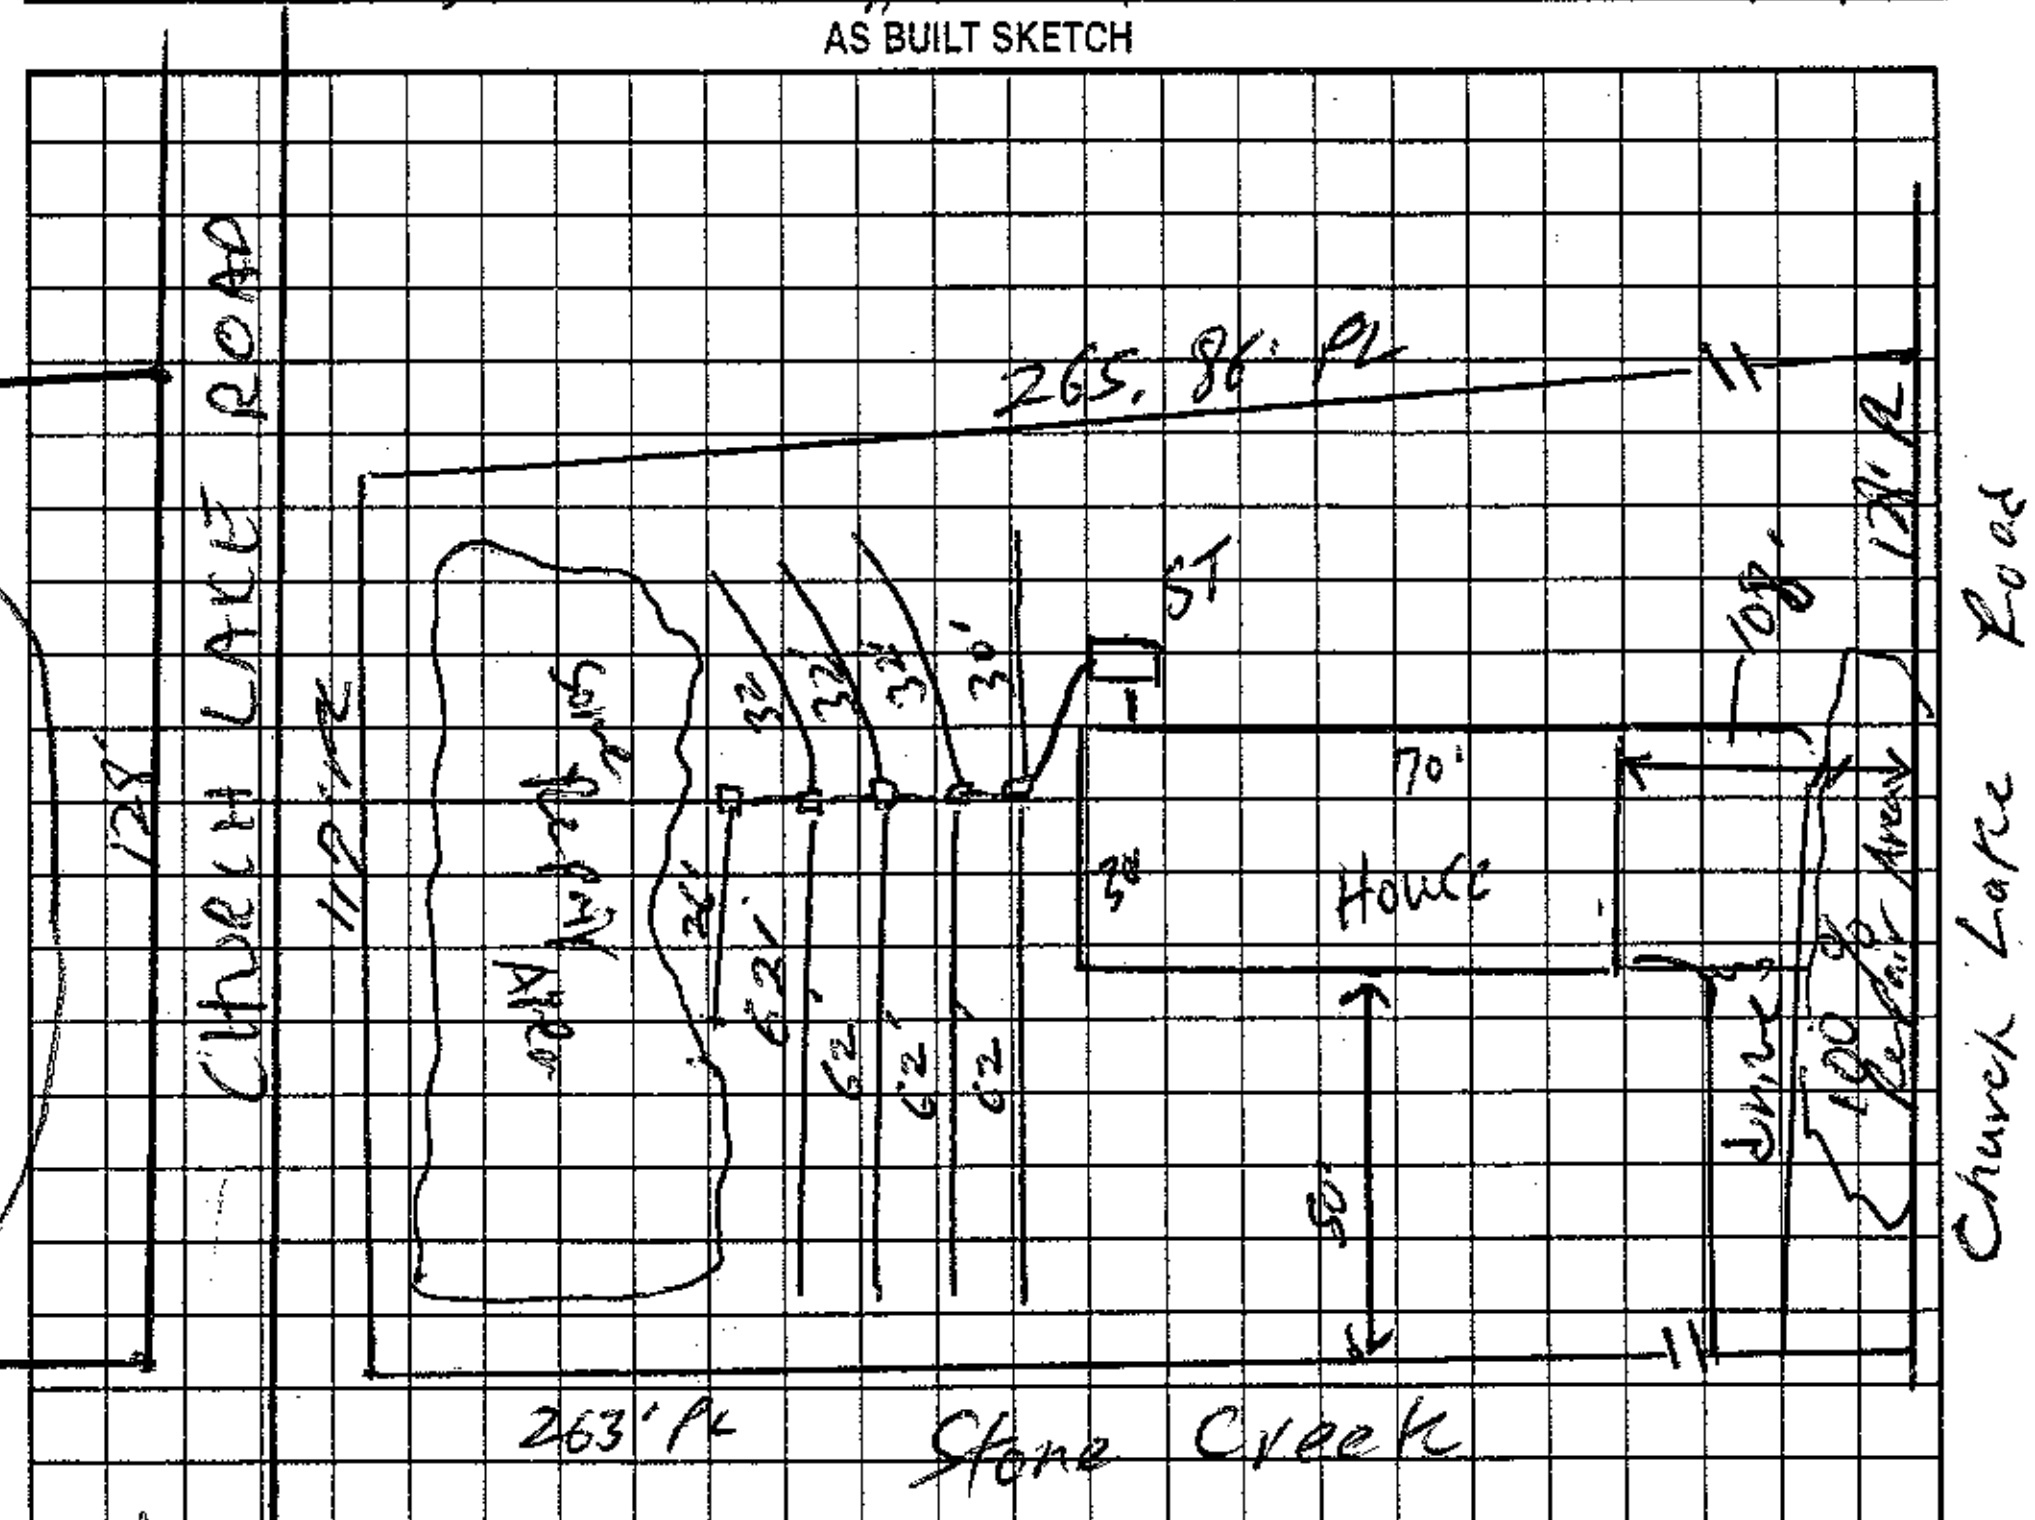

Permit can be suspended or revoked if any false information is supplied toward securing the permit/any unauthorized changes are made to the site/any unauthorized changes are made in the installation of the system. Improvement Permit with plat valid without expiration. Improvement Permit with site plan valid for sixty months. Authorization to Construct is valid for a period equal to that of Improvement Permit – not to exceed sixty months.

Signed: ______ date ______   Installed by: Alan Lewis / David Yountz - Installer

Improvement Permit by: Tom Cook RS [signature] date 4-19-01   Operation Permit by: William O. Johns [signature] date May 30-2001

Authorization to Construct by: Tom Cook RS [signature] date 4-19-01   Existing System Inspection by: ______ date ______

HEALTH DEPT. COPY: WHITE   OWNER COPY (FINAL): YELLOW   OWNER COPY (INITIAL): PINK