CI

IREDELL COUNTY HEALTH DEPARTMENT

STATESVILLE 704-878-5305 MOORESVILLE 704-664-5281

IMPROVEMENT PERMIT / AUTHORIZATION TO CONSTRUCT / OPERATION PERMIT / EXISTING SYSTEM INSPECTION

PERMIT# 092006 PIN# 4767666287 DATE 4-20-01

OWNER OR CONTRACTOR ALAN LEWIS PHONE: Business Home 721-878-2305

ADDRESS 118 NEW HOPE RD STATESVILLE, NC 28625

LOCATION OLD MOCKSVILLE RD, @ CHURCH, LANE, @ STONE CREEK, ON RIGHT

SUBDIVISION STONECREEK BLOCK / SECTION LOT 3 LOT AREA 1.75 SITE CLASS PS DESIGN FLOW 360 L.T.A.R. .13

Septic Tank: 1000 Gallons: STB 1012 Date 10-2701
Pump Tank: Gallons: PT Date
Pump Make: Model Serial No.
Nitrification Field: No Fields 1 Square Feet 1200 Linear Feet 300
No Lines 6 Trench Width 36" Max Trench Bottom Depth 36" Gravel Depth N/A

X New System ☐ Repair System Type: I (II) III IV V VI
System Description: GRAV 25% RED
Repair System Description: PUMP CONV
Maintenance Agreement Required: ☐ Yes X No

X House/Mod. Home No. Bedrooms 3
☐ Mobile Home No. Bathrooms 2
☐ Business No. Employees
☐ Other


Water Supply: ☐ Individual X Public ☐ Community

☐ Slab X Crawl Space ☐ Basement w/plumbing ☐ Basement wo/plumbing


Comments/Conditions: (1) INSTALL LINES ON CONTOUR (2) KEEP system 15' off top of ditch, 10' off property lines, & 5' off house. (3) stub out as high as possible to get fall to tank

Comments/Conditions: POLYLOK FITTINGS RISERS

INITIAL SITE SKETCH 1" = 50'

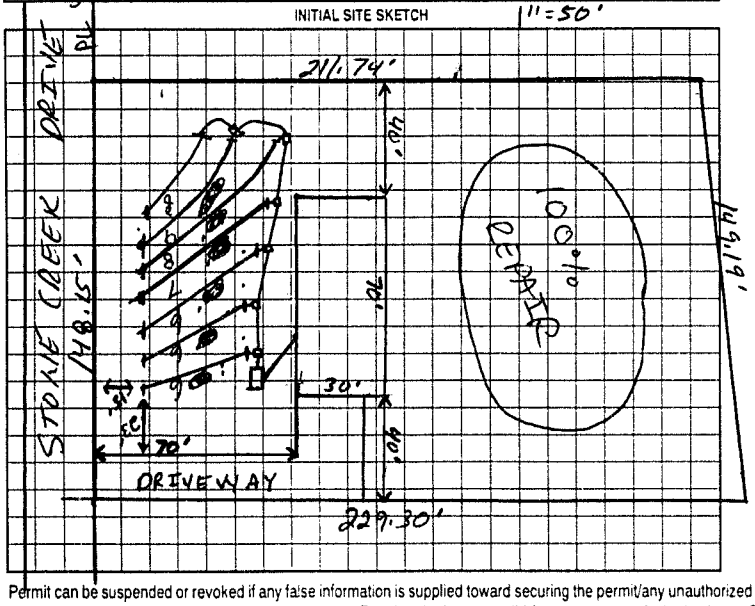

AS BUILT SKETCH

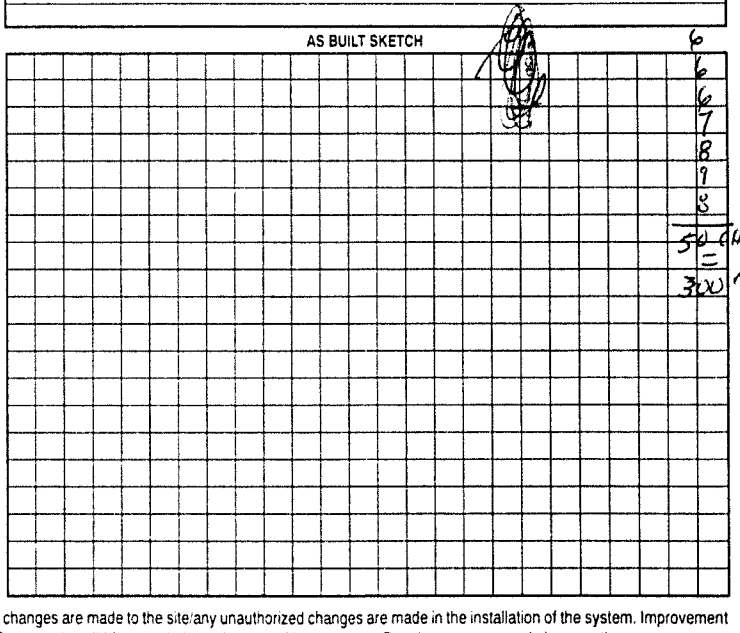

Permit can be suspended or revoked if any false information is supplied toward securing the permit/any unauthorized changes are made to the site/any unauthorized changes are made in the installation of the system. Improvement Permit with plat valid without expiration. Improvement Permit with site plan valid for sixty months. Authorization to Construct is valid for a period equal to that of Improvement Permit – not to exceed sixty months.

Signed: Alan Lewis date 7-31-01 Installed by: YOUNTZ BACKHOE

Improvement Permit by: Tim Cook RSI date 4-25-01 Operation Permit by: Tim Cook RS date 12-27-01

Authorization to Construct by: Tim Cook RSI date 4-25-01 Existing System Inspection by: date

HEALTH DEPT. COPY WHITE OWNER COPY (FINAL) YELLOW OWNER COPY (INITIAL) PINK