IREDELL COUNTY HEALTH DEPARTMENT

THIS PERMIT VOIDS PREVIOUS ISSUED 95-03

STATESVILLE 704-878-5305 (E) MOORESVILLE 704-664-5281

IMPROVEMENT PERMIT / AUTHORIZATION TO CONSTRUCT / OPERATION PERMIT / EXISTING SYSTEM INSPECTION

PERMIT# 115285 PIN# 4767-65-5991 DATE 10-16-03

OWNER OR CONTRACTOR ALAN LEWIS PHONE: Business 704-878-2305 Home 704-871-7896

ADDRESS 118 NEW HOPE ROAD, STATESVILLE NC 28677

LOCATION OLD MOCKSVILLE ROAD NE, TL CHURCHES LAKE RD, TR STONE CREEK DR, 4TH LOT ON RIGHT

SUBDIVISION STONE CREEK BLOCK / SECTION ____ LOT 5 LOT AREA 0.974 ACRE SITE CLASS. PS DESIGN FLOW 360 L.T.A.R. 0.35 GPD/FT²

Septic Tank: 1000 Gallons; ST# 1012 Date 11-3-03
Pump Tank: ____ Gallons; PT ____ Date ____
Pump Make: ____ Model ____ Serial No. ____
Nitrification Field: No Fields 4 Square Feet 1035 Linear Feet 345+
No Lines FIVE FOUR Trench Width 36" Max Trench Bottom Depth 36 Gravel Depth 12"

☑ New System ☐ Repair System Type: I (II) III, IV, V, VI
System Description: CONVENTIONAL GRAVITY
Repair System Description: 50% REDUCTION, PUMP
Maintenance Agreement Required: ☐ Yes ☑ No

☑ House/Mod. Home No. Bedrooms 3
☐ Mobile Home No. Bathrooms 2
☐ Business No. Employees ____
☐ Other ____


☐ Slab ☑ Crawl Space ☐ Basement w/plumbing ☐ Basement wo/plumbing

Water Supply: ☐ Individual ☑ Public ☐ Community


Comments:/Conditions: KEEP SYSTEM MINIMUM 10' FROM WATER LINE

Comments:/Conditions: ① SYSTEM ALTERED TO FOUR LINES AS SHOWN WITH PRIOR HEALTH DEPT. APPROVAL ② SEPTIC TANK WITH MARKER INSTALLED USING "TUFTITE" FILTER

INITIAL SITE SKETCH

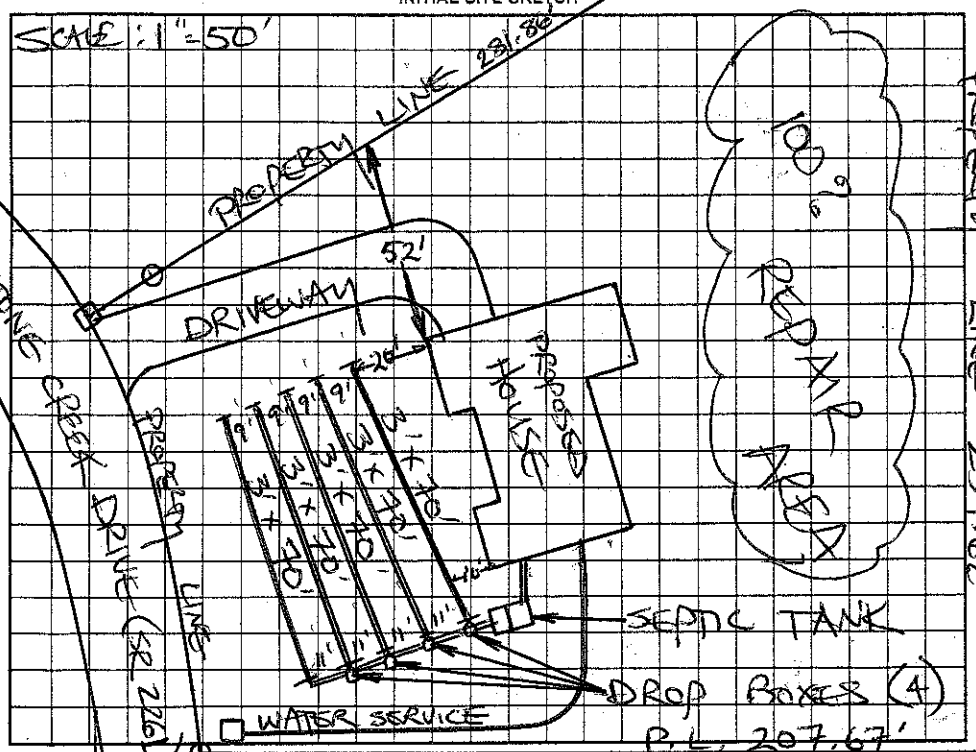

AS BUILT SKETCH

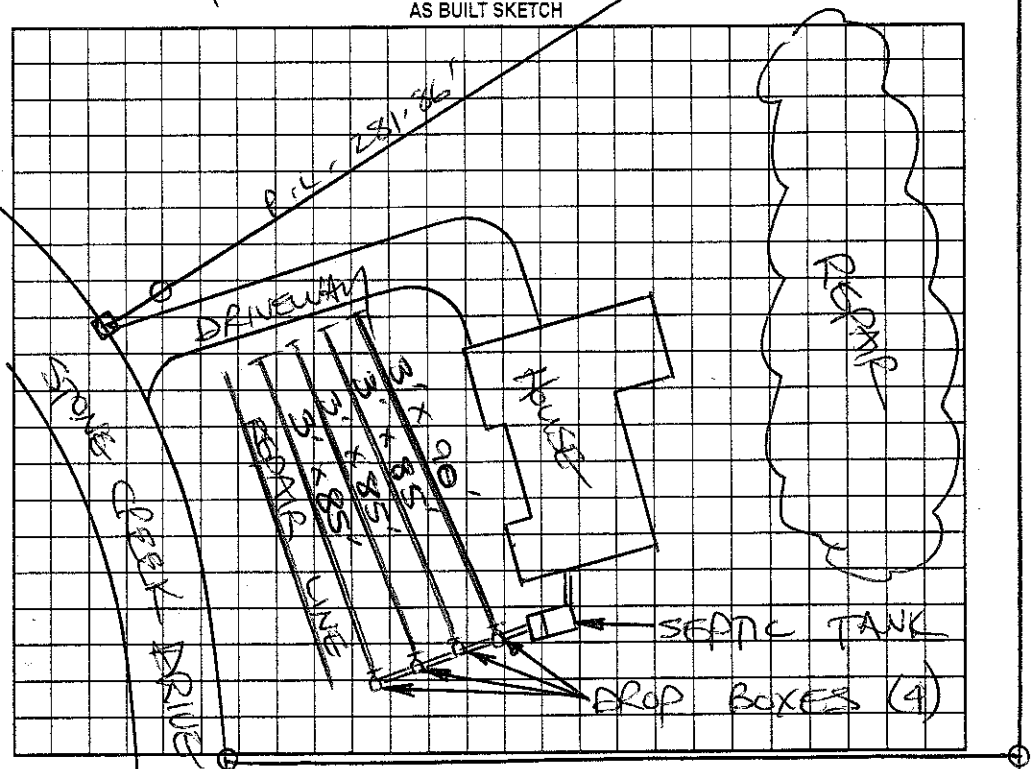

Permit can be suspended or revoked if any false information is supplied toward securing the permit/any unauthorized changes are made to the site/any unauthorized changes are made in the installation of the system. Improvement Permit with plat valid without expiration. Improvement Permit with site plan valid for sixty months. Authorization to Construct is valid for a period equal to that of Improvement Permit – not to exceed sixty months.

Signed: Alan Lewis date 10-16-03 Installed by: DAVID YOUNTZ

Improvement Permit by: STEVE HEDRICK date 10-16-03 Operation Permit by: STEVE HEDRICK date 4-28-04

Authorization to Construct by: STEVE HEDRICK date 10.16.03 Existing System Inspection by: ____ date ____

HEALTH DEPT. COPY: WHITE OWNER COPY (FINAL): YELLOW OWNER COPY (INITIAL): PINK