IREDELL COUNTY HEALTH DEPARTMENT

STATESVILLE 704-878-5305 MOORESVILLE 704-664-5281

IMPROVEMENT PERMIT / AUTHORIZATION TO CONSTRUCT / OPERATION PERMIT / EXISTING SYSTEM INSPECTION

PERMIT# 88551 PIN# 4767 66 6287 DATE 4-17-00

OWNER OR CONTRACTOR Alan Lewis PHONE: Business 878 2305 Home

ADDRESS 118 New Hope Rd statesville

LOCATION Old mocksville Tb Churchen Lake Rd TR Stone Creek Tb mill Branch 3rd Left

SUBDIVISION Stone Creek BLOCK / SECTION LOT 26 LOT AREA .83 acres SITE CLASS PS DESIGN FLOW 360 L.T.A.R. .33

Septic Tank: 1000 Gallons: STB 1017 Date 6-28-00
Pump Tank: Gallons: PT Date
Pump Make: Model 1080 Serial No. 360
Nitrification Field: No Fields 1 Square Feet ~~[illegible]~~ Linear Feet ~~[illegible]~~
No Lines 4 Trench Width 36" Max Trench Bottom Depth 36" Gravel Depth 12"

☑ New System ☐ Repair System Type: I (II) III IV V VI
System Description: Conv. Gravity
Repair System Description: Pump To 25% Red.
Maintenance Agreement Required: ☐ Yes ☑ No


☑ House/Mod. Home No. Bedrooms 3
☐ Mobile Home No. Bathrooms 2
☐ Business No. Employees
☐ Other

☐ Slab ☑ Crawl Space ☐ Basement w/plumbing ☐ Basement wo/plumbing

Water Supply: ☐ Individual ☑ Public ☐ Community


Comments/Conditions: 221'

INITIAL SITE SKETCH

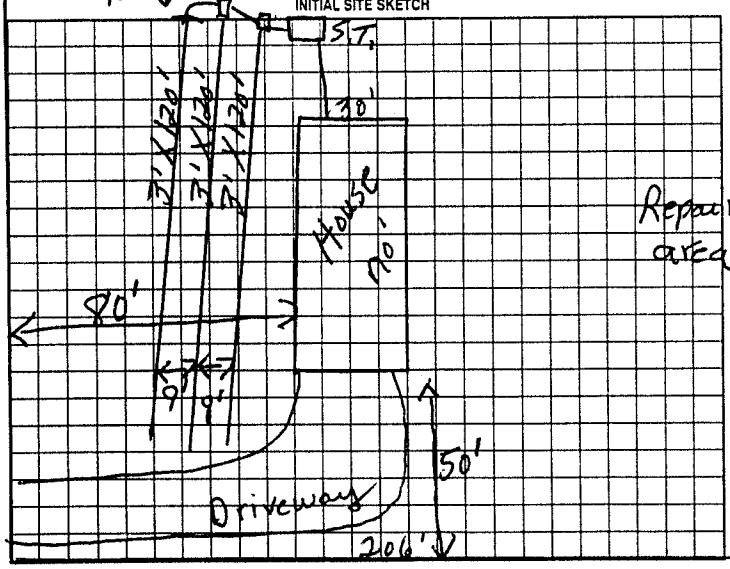

Comments/Conditions:

AS BUILT SKETCH

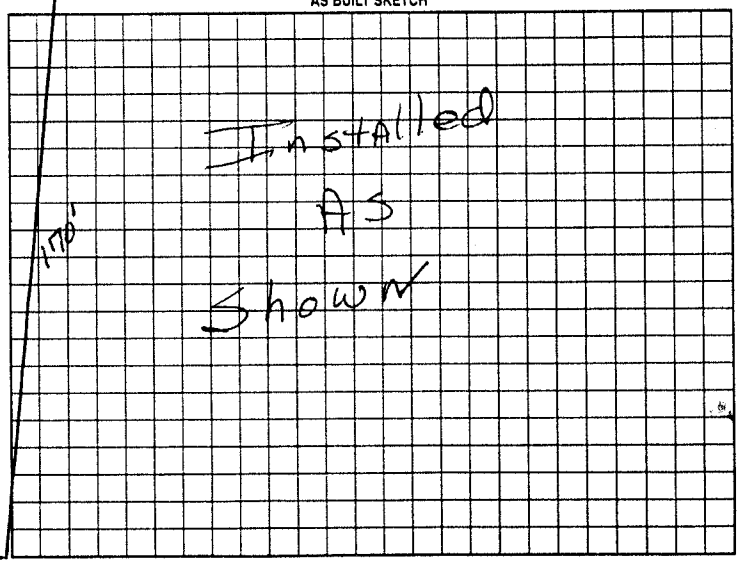

Permit can be suspended or revoked if any false information is supplied toward securing the permit/any unauthorized changes are made to the site/any unauthorized changes are made in the installation of the system. Improvement Permit with plat valid without expiration. Improvement Permit with site plan valid for sixty months. Authorization to Construct is valid for a period equal to that of Improvement Permit – not to exceed sixty months.

Signed: Alan E. Lewis date

Improvement Permit by: P.C. Moore date 4-17-00

Authorization to Construct by: P.C. Moore date 4-17-00

Installed by: Tommy Frye

Operation Permit by: [illegible] RS date 10-17-00

Existing System Inspection by: date ~~[illegible]~~

HEALTH DEPT. COPY: WHITE OWNER COPY (FINAL): YELLOW OWNER COPY (INITIAL): PINK