200-230

IREDELL COUNTY HEALTH DEPARTMENT

STATESVILLE 704-878-5305 MOORESVILLE 704-664-5281

IMPROVEMENT PERMIT / AUTHORIZATION TO CONSTRUCT / OPERATION PERMIT / EXISTING SYSTEM INSPECTION

PERMIT# 089535 PIN# 4767666287 (Lot) DATE June 5, 2000

OWNER OR CONTRACTOR Alan Lewis PHONE: Business 878-2305 Home

ADDRESS 118 New Hope Rd. Statesville 28625

LOCATION Old Mocksville Rd. TL Church Lake Rd TR Stone Creek TL Millbranch AT END on left

SUBDIVISION Stone Creek BLOCK / SECTION LOT 25 LOT AREA .83± SITE CLASS. PS DESIGN FLOW 360 GPD L.T.A.R. .3

Septic Tank: 1000 Gallons: STB 1012 Date 4-15-00

Pump Tank: Gallons; PT Date

Pump Make: Model Serial No.

Nitrification Field: No Fields 1 Square Feet 1200 Linear Feet 400

No Lines 3 Trench Width 36" Max Trench Bottom Depth 36" Gravel Depth 12"

☑ New System ☐ Repair System Type: I II III IV V VI

System Description: GRAVITY CONVENTIONAL

Repair System Description: ~~GRAVITY INNOVATIVE 25%Red.~~

Maintenance Agreement Required: ☐ Yes ☑ No

☑ House/Mod. Home ☐ Mobile Home ☐ Business ☐ Other

No. Bedrooms 3 No. Bathrooms 2 No. Employees

Water Supply: ☐ Individual ☑ Public ☐ Community


☐ Slab ☑ Crawl Space ☐ Basement w/plumbing ☐ Basement wo/plumbing

Comments:/Conditions:


D Box = Levelers

Comments:/Conditions.

INITIAL SITE SKETCH 1" = 60'

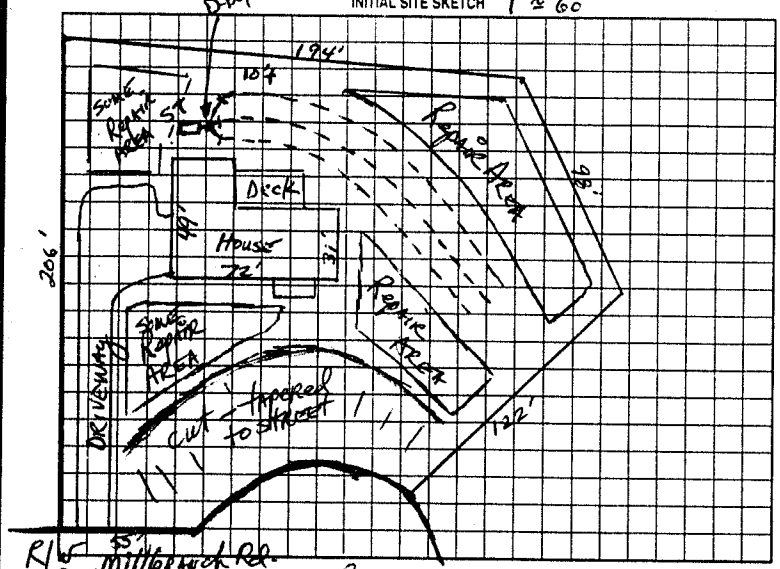

AS BUILT SKETCH

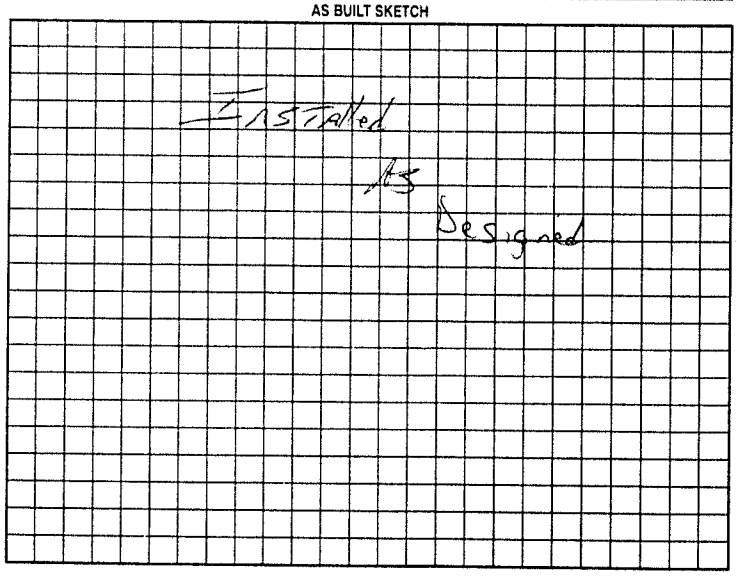

Permit can be suspended or revoked if any false information is supplied toward securing the permit/any unauthorized changes are made to the site/any unauthorized changes are made in the installation of the system. Improvement Permit with plat valid without expiration. Improvement Permit with site plan valid for sixty months. Authorization to Construct is valid for a period equal to that of Improvement Permit – not to exceed sixty months.

Signed: Alan Lewis date

Improvement Permit by: date 6-5-00

Authorization to Construct by: date 6-5-00

Installed by: David Young

Operation Permit by: date 6/14/2000

Existing System Inspection by: date

HEALTH DEPT. COPY: WHITE OWNER COPY (FINAL): YELLOW OWNER COPY (INITIAL): PINK