IREDELL COUNTY HEALTH DEPARTMENT

STATESVILLE 704-878-5305 MOORESVILLE 704-664-5281

IMPROVEMENT PERMIT / AUTHORIZATION TO CONSTRUCT / OPERATION PERMIT / EXISTING SYSTEM INSPECTION

PERMIT# 122039 PIN# 4767-66-4153 DATE 7-2-04

OWNER OR CONTRACTOR BOBBY ANDERSON PHONE: Business 704-902-7421 Home 704-546-2273

ADDRESS 239 KINDER ROAD HARMONY NC 28634

LOCATION OLD MOCKSVILLE ROAD, TR CHURCH LAKE ROAD, TR STONE CREEK DRIVE TL MILL BRANCH 1ST ON (R)

SUBDIVISION STONE CREEK BLOCK / SECTION ____ LOT 19 LOT AREA 0.987 ACRE SITE CLASS. PS DESIGN FLOW 360 L.T.A.R. 0.30 GAD/FT²

Septic Tank: 1000 Gallons; STB 1012 Date 6-29-04
Pump Tank: ____ Gallons; PT ____ Date ____
Pump Make: ____ Model ____ Serial No. ____
Nitrification Field: No Fields ☐ Square Feet 1200 Linear Feet 400
No Lines EVEN Trench Width 36" Max Trench Bottom Depth 36" Gravel Depth 12"

☑ New System ☐ Repair System Type: I II III IV V VI
System Description: 25% RED CONVENTIONAL GRAVITY
Repair System Description: 50% REDUCTION, GRAVITY
Maintenance Agreement Required: ☐ Yes ☑ No


☐ House/Mod. Home No. Bedrooms 3
☐ Mobile Home No. Bathrooms 2
☐ Business No. Employees ____
☐ Other ____
☐ Slab ☑ Crawl Space ☑ Basement w/plumbing ☐ Basement wo/plumbing

Water Supply: ☐ Individual ☑ Public ☐ Community


Comments:/Conditions:

Comments:/Conditions: SYSTEM ALTERED AS SHOWN BELOW USING 48 "INFILTRATOR" CHAMBERS. SEPTIC TANK WITH MARKER INSTALLED USING "TUFTITE" FILTER

INITIAL SITE SKETCH

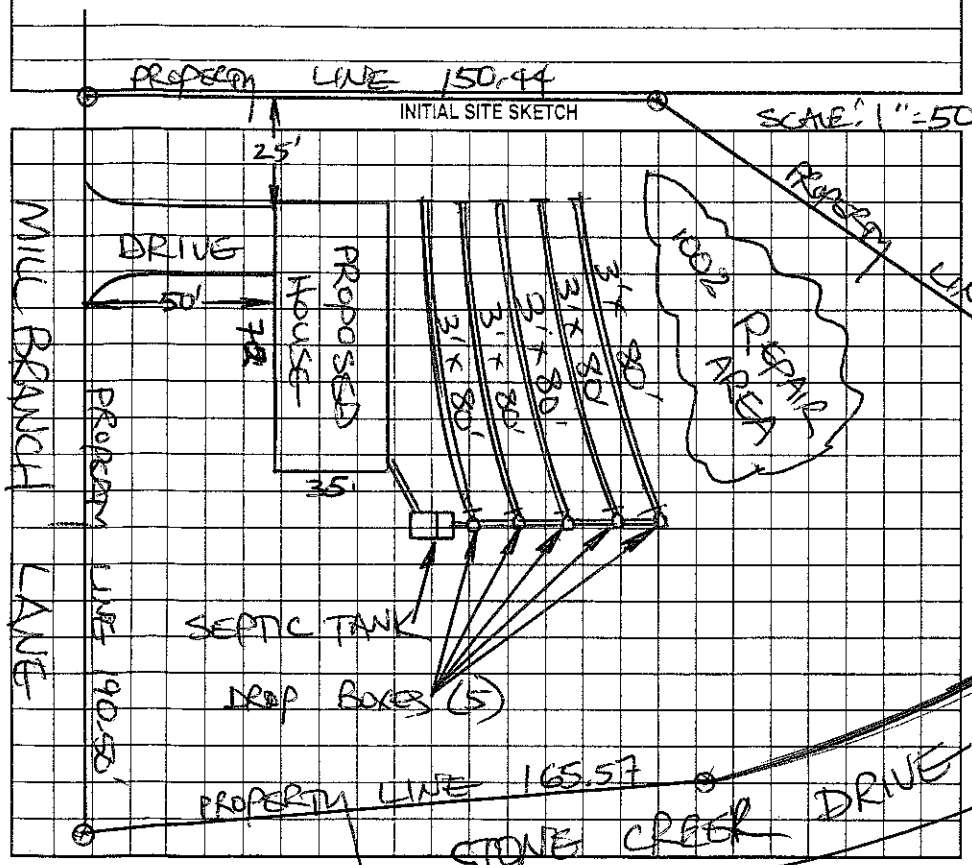

AS BUILT SKETCH

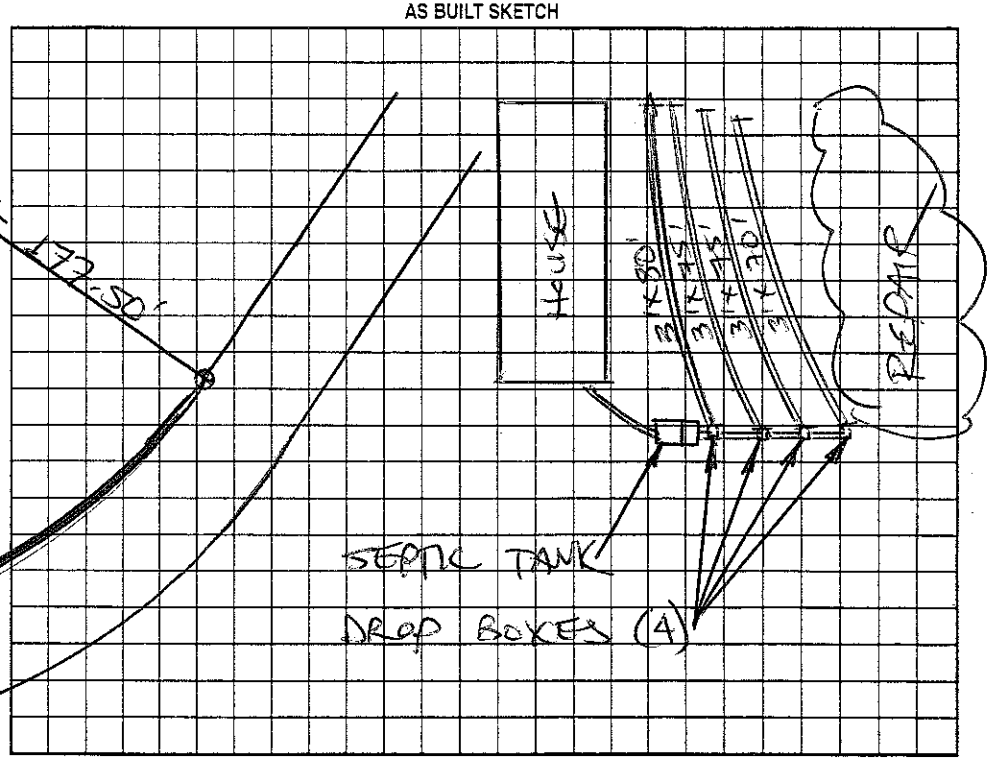

Permit can be suspended or revoked if any false information is supplied toward securing the permit/any unauthorized changes are made to the site/any unauthorized changes are made in the installation of the system. Improvement Permit with plat valid without expiration. Improvement Permit with site plan valid for sixty months. Authorization to Construct is valid for a period equal to that of Improvement Permit – not to exceed sixty months.

Signed: Bobby Anderson date 7-2-04
Improvement Permit by: STEVE HEDRICK date 7-2-04
Authorization to Construct by: STEVE HEDRICK date 7-2-04

Installed by: TOMMY FRYE
Operation Permit by: STEVE HEDRICK date 12-15-04
Existing System Inspection by: ____ date ____

HEALTH DEPT. COPY: WHITE OWNER COPY (FINAL): YELLOW OWNER COPY (INITIAL): PINK