IREDELL COUNTY HEALTH DEPARTMENT

STATESVILLE 704-878-5305 (CI) MOORESVILLE 704-664-5281

IMPROVEMENT PERMIT / AUTHORIZATION TO CONSTRUCT / OPERATION PERMIT / EXISTING SYSTEM INSPECTION

PERMIT# 42175 PIN# 4767668140 DATE 30 May 07

OWNER OR APPLICANT Alan E Lewis PHONE: Business ______ Home ______

ADDRESS 118 New Hope RD Statesville NC 28118

LOCATION 21 N (R) Dulap Gate (L) Old Mocksville (R) Church Lake (R) Stone Creek on left

SUBDIVISION Stone Creek BLOCK / SECTION ______ LOT 7 LOT AREA .88 SITE CLASS. PS DESIGN FLOW 360 L.T.A.R. .3

Septic Tank: 1000 Gallons; STB 1012 Date 3-20-07
Pump Tank: ______ Gallons; PT ______ Date ______
Pump Make: ______ Model ______ Serial No. ______
Nitrification Field: No Fields ____ Square Feet 1200 Linear Feet 320
No Lines 3 Trench Width 36" Max Trench Bottom Depth 36" Gravel Depth ______ ☐ Gravity ☐ Pressure

☑ New System ☐ Repair ☐ Expansion System Type: I (II) III IV V VI
System Description: 25% Reduction [illegible]
Repair System Description: 50% Con [illegible]
Maintenance Agreement Required: ☐ Yes ☐ No

☑ House/Mod. Home ☐ Mobile Home ☐ Business ☐ Other ______
No. Bedrooms 3 No. Persons ______ No. Employees ______


Water Supply: ☐ Individual ☑ Public ☐ Community

☐ Slab ☐ Crawl Space ☑ Basement w/plumbing ☐ Basement wo/plumbing


Comments:/Conditions:

Comments:/Conditions: Daylight Basement at Stakes. Install on Contours - Maintain all setbacks

INITIAL SITE SKETCH

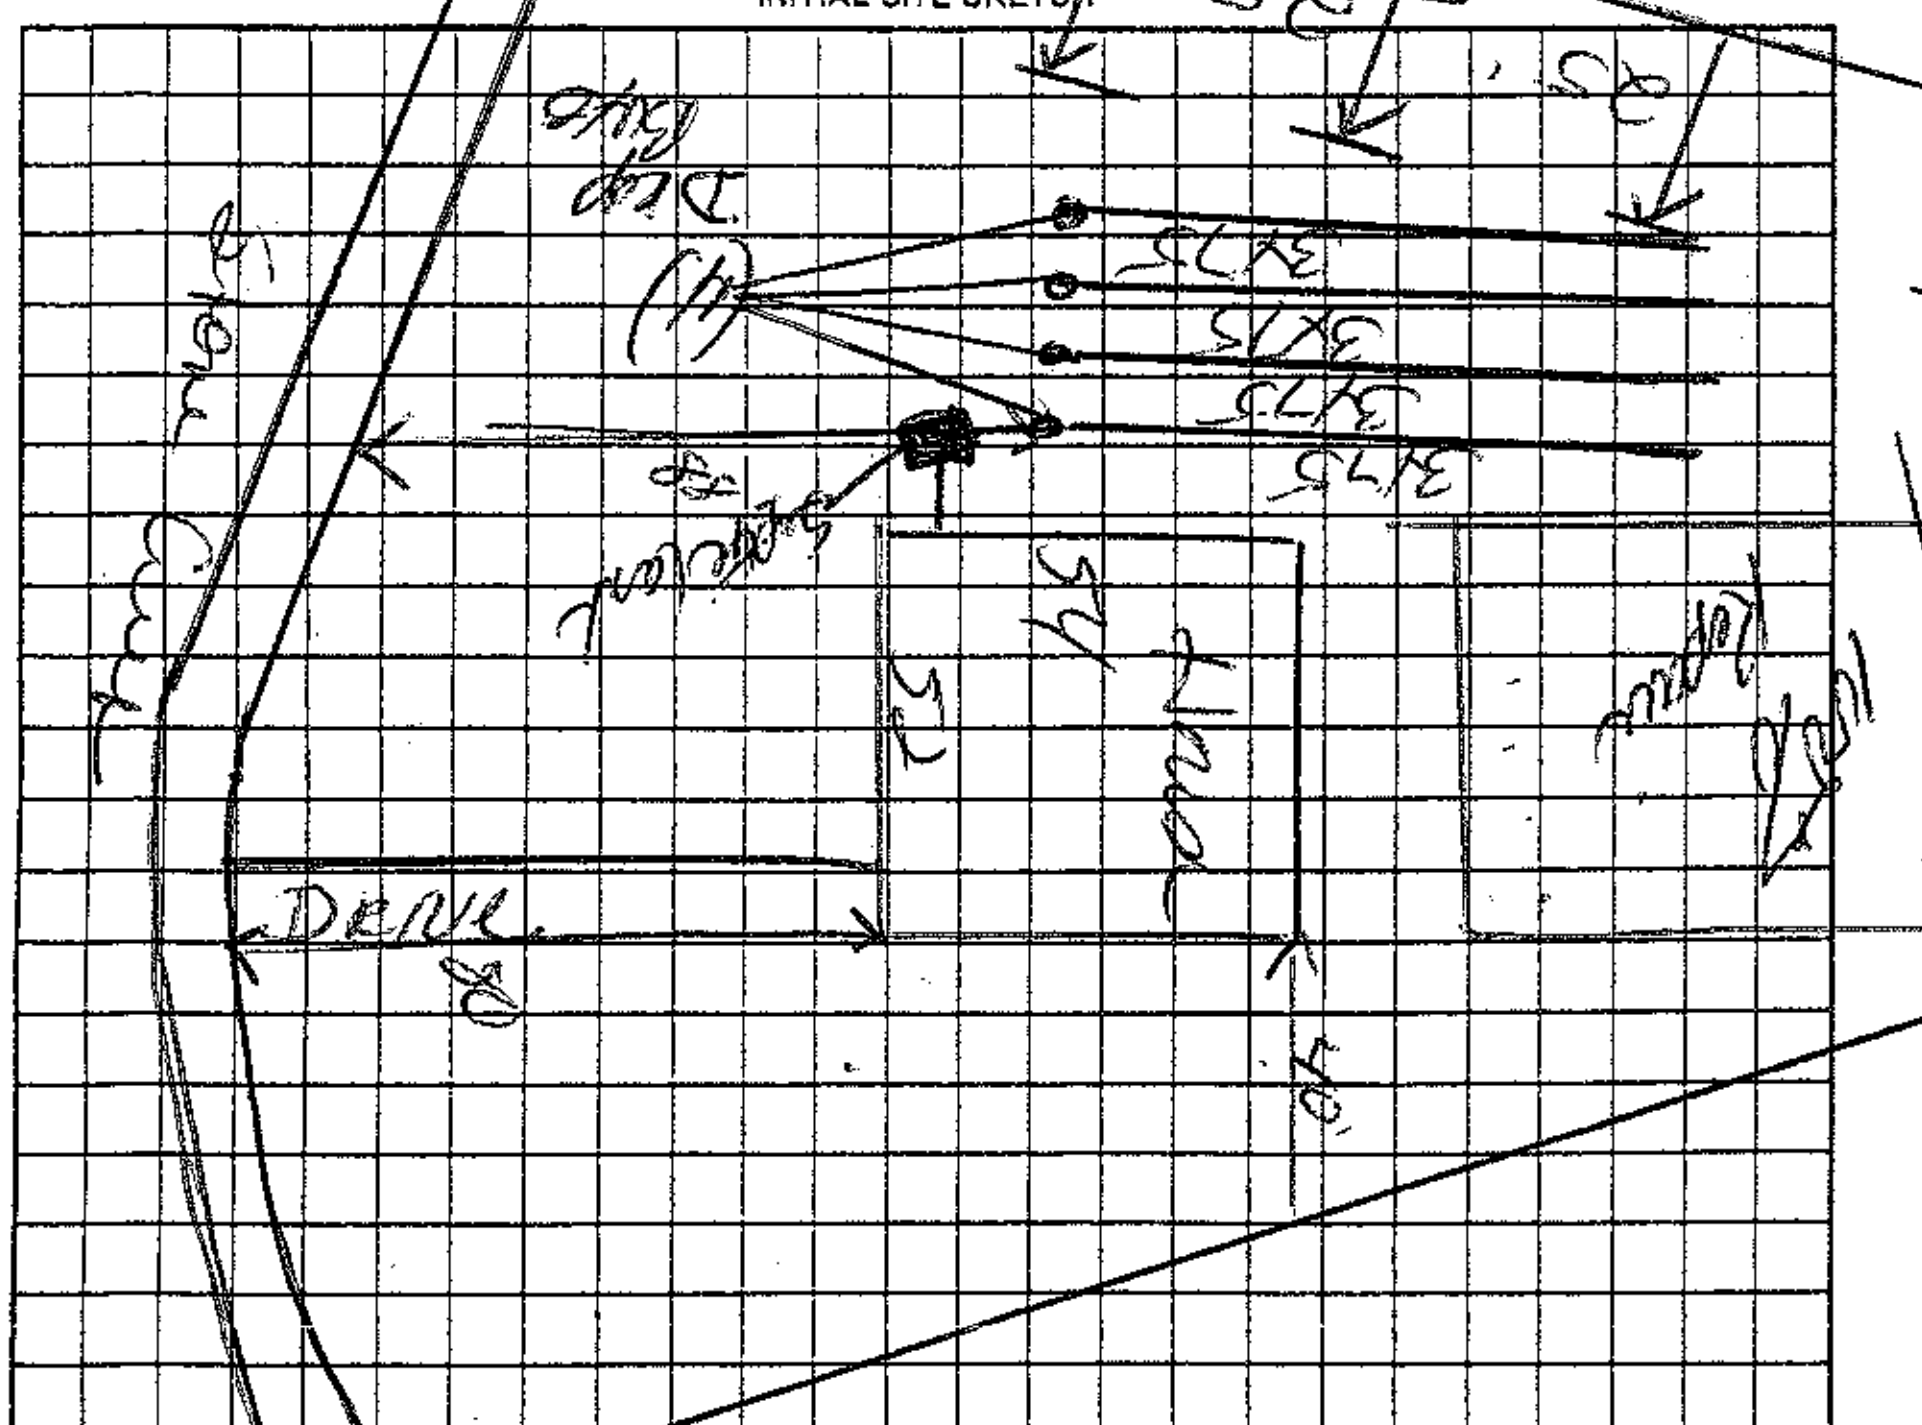

AS BUILT SKETCH

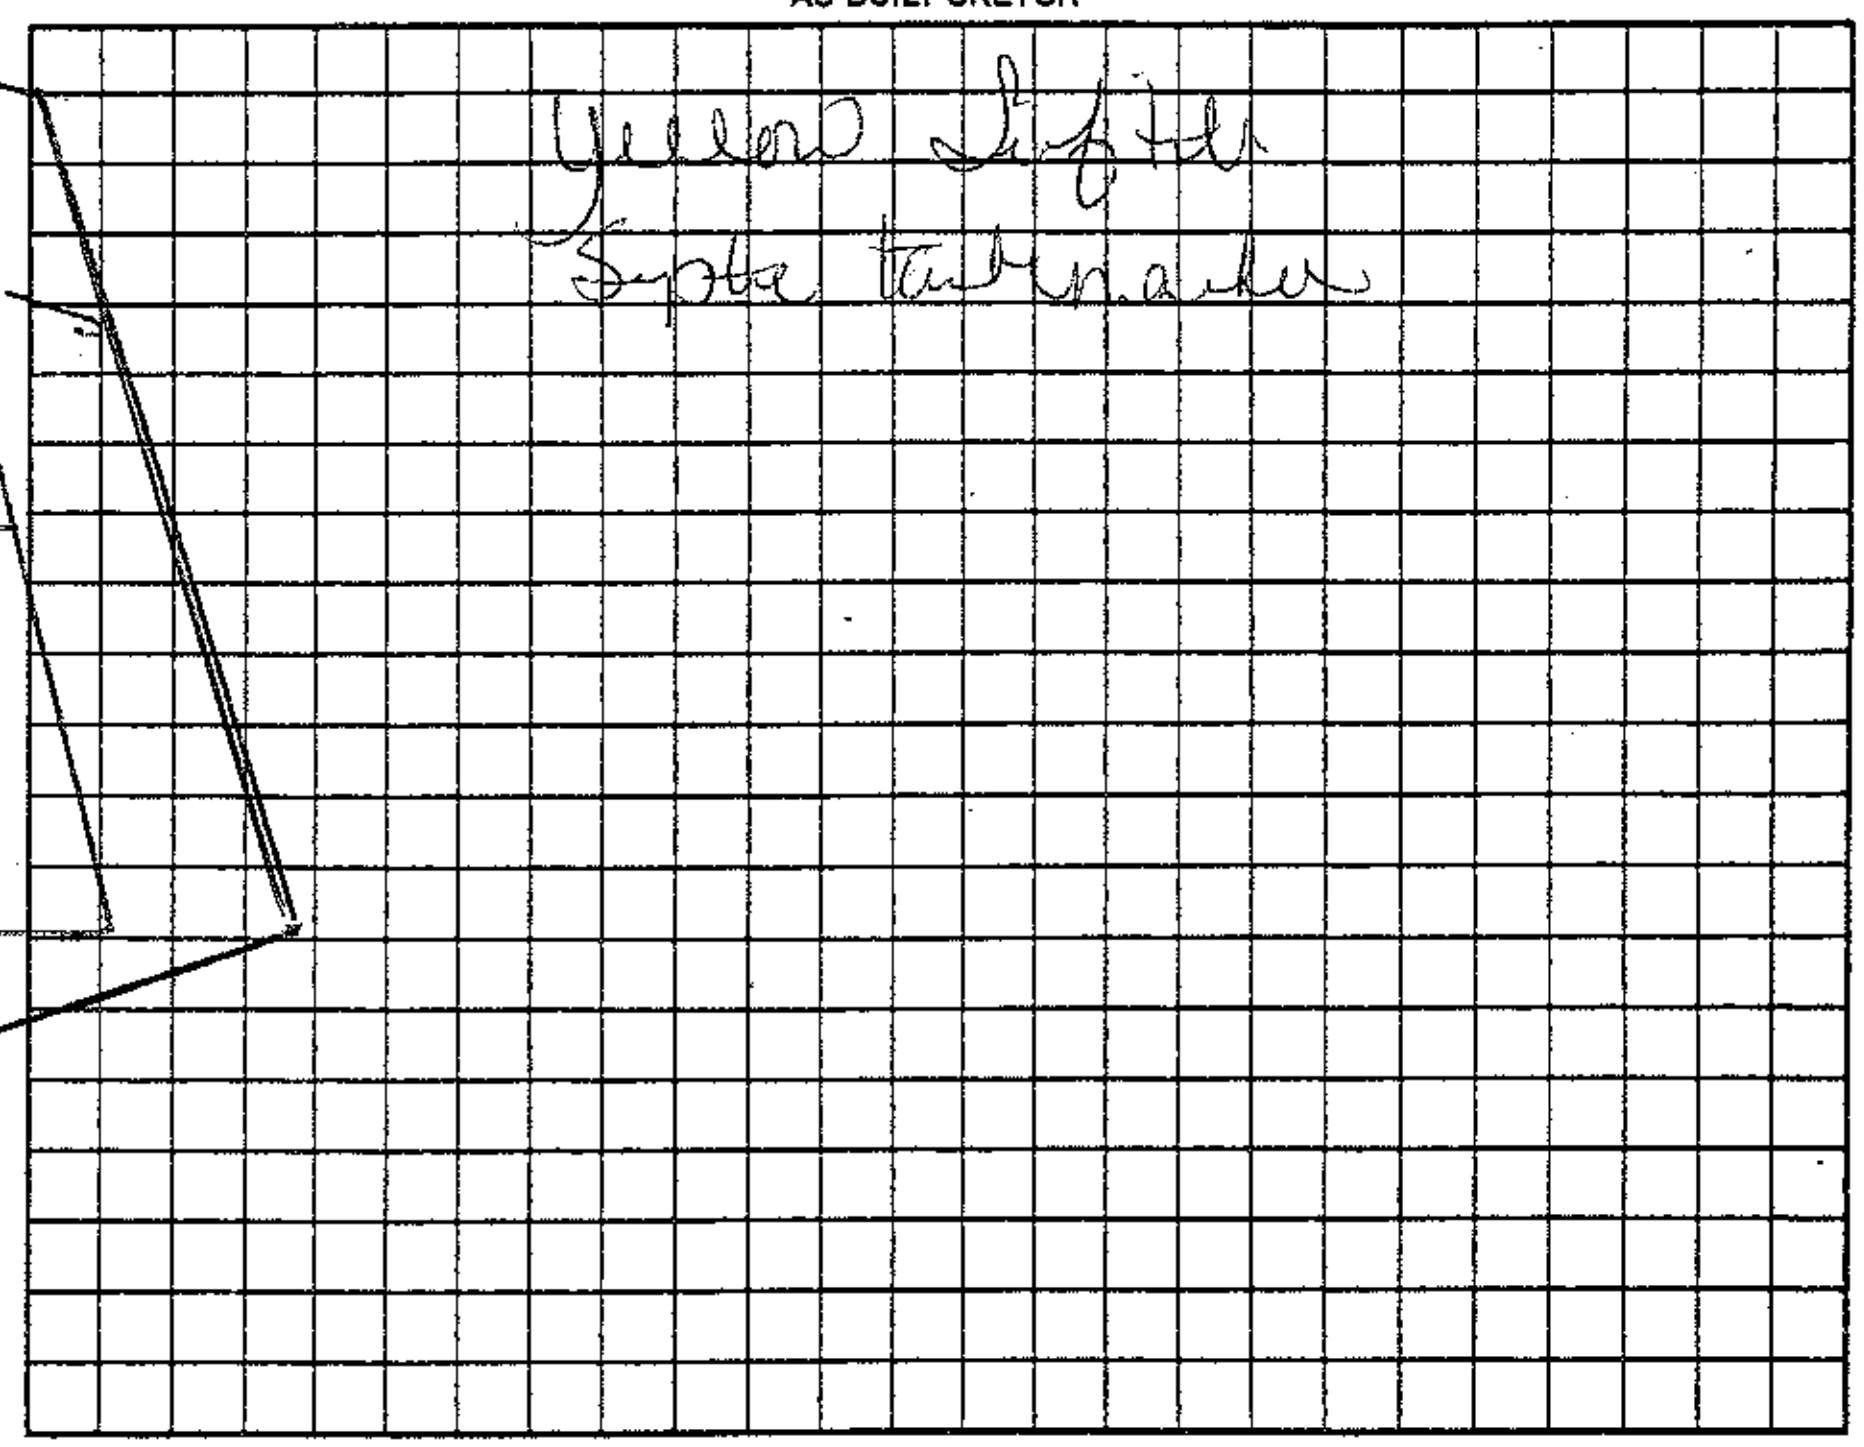

Permit can be suspended or revoked if any false information is supplied toward securing the permit/any unauthorized changes are made to the site/any unauthorized changes are made in the installation of the system. Improvement Permit with plat valid without expiration ☐ Improvement Permit with site plan valid for sixty months ☐ Authorization to Construct is valid for a period equal to that of Improvement Permit – not to exceed sixty months.

Signed: Alan Lewis date ______ Installed by: DAVID Yantz

Improvement Permit by: Kevin Cook date 31 May 07 Operation Permit by: Kevin Cook date 9-24-07

Authorization to Construct by: Kevin Cook date 31 May 07 Existing System Inspection by: ______ date ______

HEALTH DEPT. COPY: WHITE OWNER COPY (FINAL): YELLOW OWNER COPY (INITIAL): PINK