IREDELL COUNTY HEALTH DEPARTMENT

THIS PERMIT VOIDS PREVIOUS ISSUED 7-6-04

STATESVILLE 704-878-5305 MOORESVILLE 704-664-5281

IMPROVEMENT PERMIT / AUTHORIZATION TO CONSTRUCT / OPERATION PERMIT / EXISTING SYSTEM INSPECTION

PERMIT# 107083 PIN# 4767-66-8316 DATE 3-8-05

OWNER OR CONTRACTOR Bobby ANDERSON PHONE: Business 704-902-7421 Home 704-546-2273

ADDRESS 239 KINDER ROAD HARMONY NC 28634

LOCATION OLD MOCKSVILLE RD, TL CHURCH'S LAKE RD, TR STONE CREEK DR, 3RD LOT ON LEFT PAST MILLBRANCH DR.

SUBDIVISION STONE CREEK BLOCK / SECTION ____ LOT 17 LOT AREA 1.169 ACRES SITE CLASS. PS DESIGN FLOW 360 L.T.A.R. 0.40 GPD/FT²

Septic Tank: 1000 Gallons; STB 1012-100 Date 1-25-05

Pump Tank: ____ Gallons; PT ____ Date ____

Pump Make: ____ Model ____ Serial No. 225

Nitrification Field: No Fields 1 Square Feet 900 Linear Feet 300

No Lines THREE Trench Width 36" Max Trench Bottom Depth 30" Gravel Depth 12"

☑ New System ☐ Repair System Type: I (II) III, IV, V, VI

System Description: CONVENTIONAL GRAVITY

Repair System Description: 25% REDUCTION, PUMP

Maintenance Agreement Required: ☐ Yes ☑ No

☑ House/Mod. Home No. Bedrooms 3

☐ Mobile Home No. Bathrooms ____

☐ Business No. Employees ____


☐ Other ____

☐ Slab ☑ Crawl Space ☐ Basement w/plumbing ☐ Basement wo/plumbing

Water Supply: ☐ Individual ☑ Public ☐ Community


Comments:/Conditions:

INITIAL SITE SKETCH

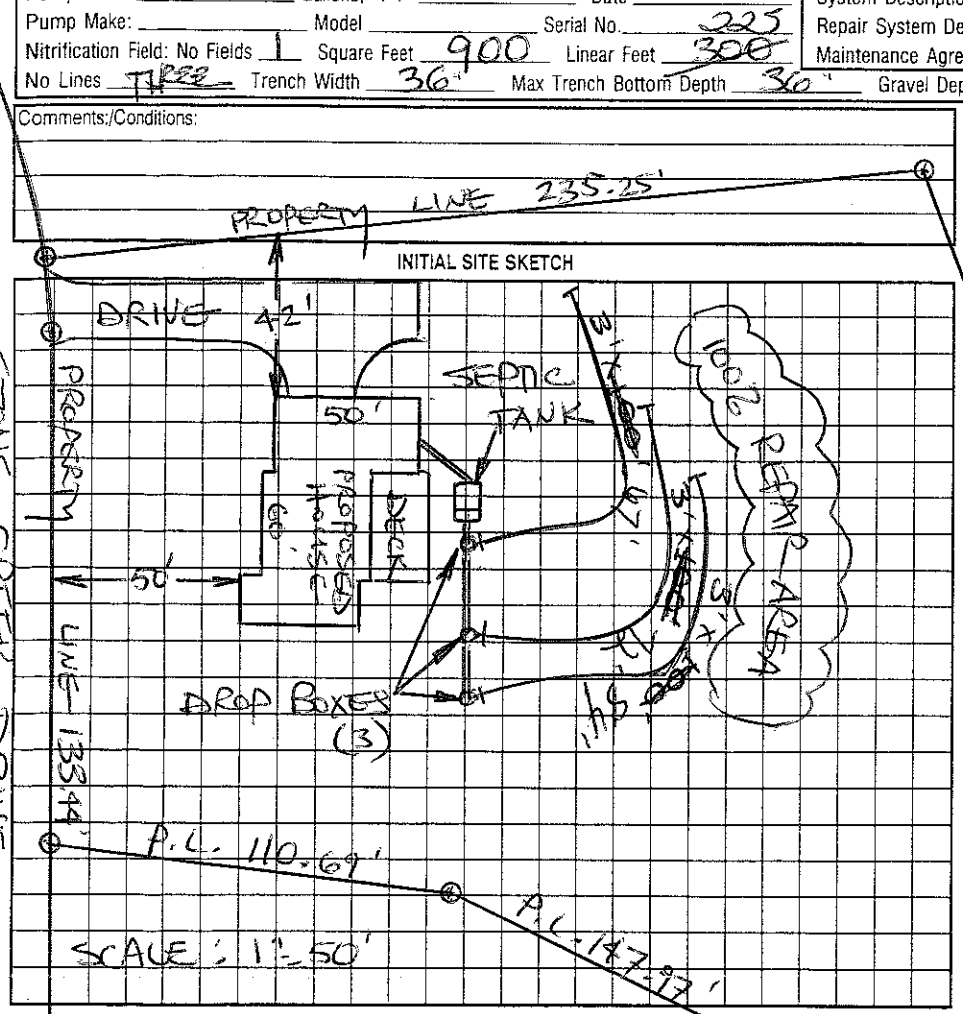

Comments:/Conditions: Yellow Tuff-Kote filter installed
Septic tank marker installed
Sle quench & Infiltrator installed

AS BUILT SKETCH

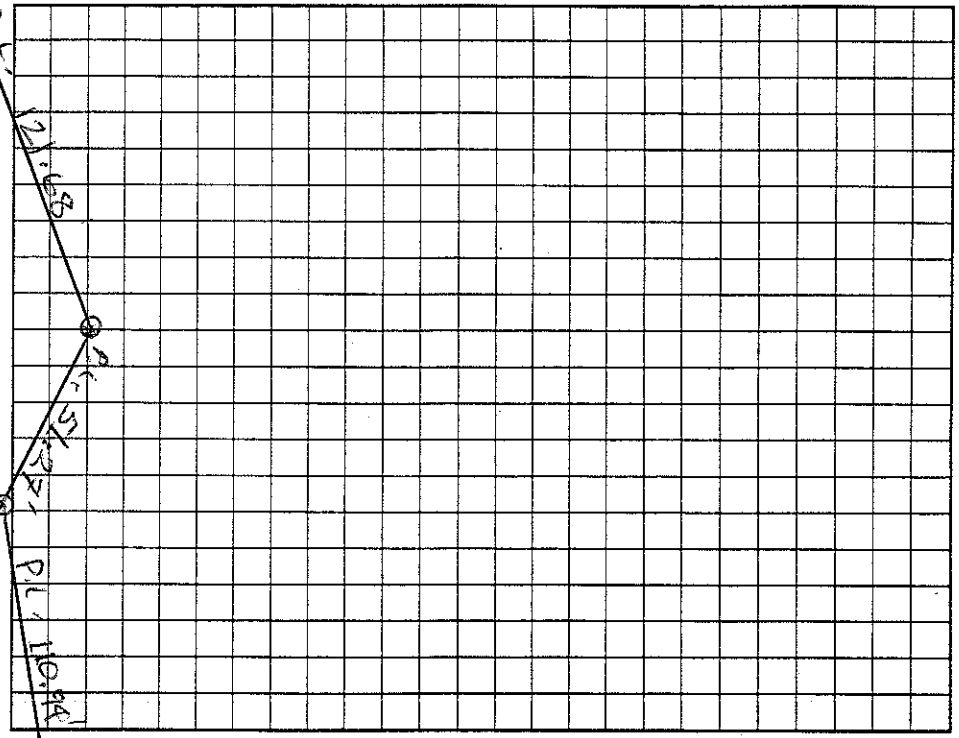

Permit can be suspended or revoked if any false information is supplied toward securing the permit/any unauthorized changes are made to the site/any unauthorized changes are made in the installation of the system. Improvement Permit with plat valid without expiration. Improvement Permit with site plan valid for sixty months. Authorization to Construct is valid for a period equal to that of Improvement Permit – not to exceed sixty months.

Signed: Bobby Anderson date 3-9-05 Installed by: Tommy Ryle

Improvement Permit by: STEVE HEDRICK date 3-8-05 Operation Permit by: [signature] date 7-15-05

Authorization to Construct by: STEVE HEDRICK date 3-8-05 Existing System Inspection by: ____ date ____

HEALTH DEPT. COPY: WHITE OWNER COPY (FINAL): YELLOW OWNER COPY (INITIAL): PINK