IREDELL COUNTY HEALTH DEPARTMENT

STATESVILLE 704-878-5305 (C1) MOORESVILLE 704-664-5281

IMPROVEMENT PERMIT / AUTHORIZATION TO CONSTRUCT / OPERATION PERMIT / EXISTING SYSTEM INSPECTION

PERMIT# 123408 PIN# 4767-66-8821 DATE 8-23-04

OWNER OR CONTRACTOR ALAN LEWIS PHONE: Business 704-871-7896 Home 704-878-2305

ADDRESS 118 NEW HOPE ROAD, STATESVILLE NC 28625

LOCATION OLD MOCKSVILLE RD NE, TL CHURCHES LAKE RD, TR STONE CREEK DR, TL MILLBRANCH, END on Right

SUBDIVISION STONE CREEK BLOCK / SECTION ____ LOT 23 LOT AREA 1.962 ACRE SITE CLASS. PS DESIGN FLOW 360 L.T.A.R. 0.40 GPD/FT2

Septic Tank: 1000 Gallons; STB 1012 Date 7-13-04
Pump Tank: ____ Gallons; PT ____ Date ____
Pump Make: ____ Model ____ Serial No. ____
Nitrification Field: No Fields 1 Square Feet 900 Linear Feet 300
No Lines THREE Trench Width 36" Max Trench Bottom Depth 36" Gravel Depth 12"

☑ New System ☐ Repair System Type: I (II) III, IV, V, VI
System Description: CONVENTIONAL, GRAVITY
Repair System Description: CONVENTIONAL, GRAVITY
Maintenance Agreement Required: ☐ Yes ☑ No


☑ House/Mod. Home No. Bedrooms 3
☐ Mobile Home No. Bathrooms ____
☐ Business No. Employees ____
☐ Other ____
☐ Slab ☑ Crawl Space ☐ Basement w/plumbing ☐ Basement wo/plumbing

Water Supply:
☐ Individual
☑ Public
☐ Community

Comments:/Conditions: KEEP SYSTEM MINIMUM 10 FEET FROM PROPERTY LINE

Comments:/Conditions: SEPTIC TANK WITH MARKER INSTALLED ~~ACCORDING~~ USING "TUFTITE" FILTER

INITIAL SITE SKETCH

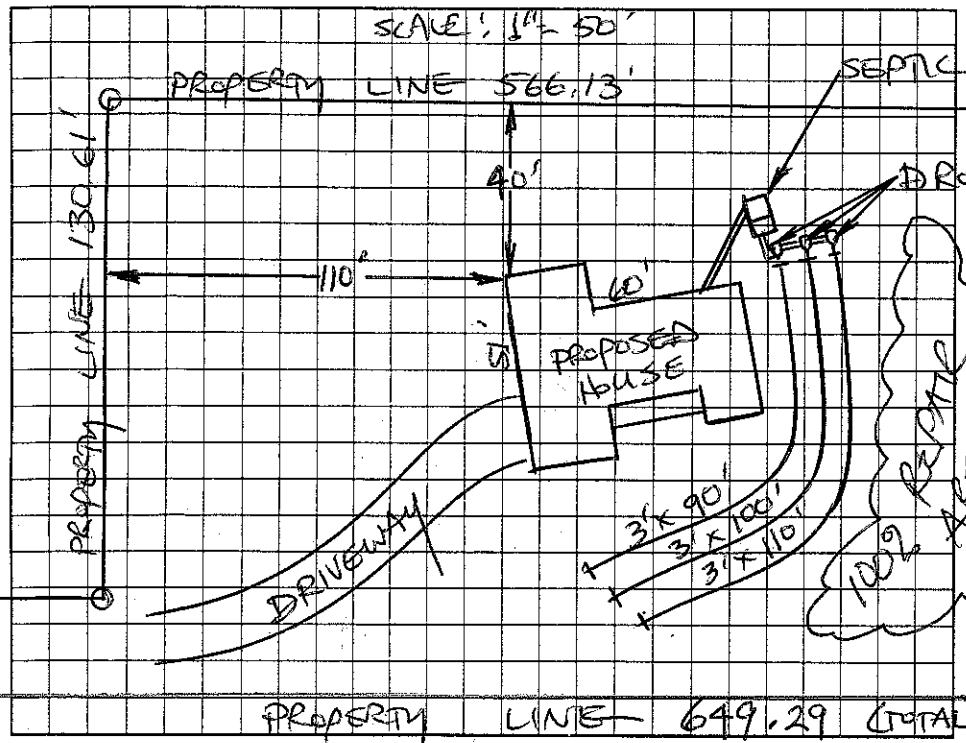

AS BUILT SKETCH

SYSTEM INSTALLED ACCORDING TO INITIAL SITE SKETCH

Permit can be suspended or revoked if any false information is supplied toward securing the permit/any unauthorized changes are made to the site/any unauthorized changes are made in the installation of the system. Improvement Permit with plat valid without expiration. Improvement Permit with site plan valid for sixty months. Authorization to Construct is valid for a period equal to that of Improvement Permit – not to exceed sixty months.

Signed: Alan Lewis date 8-24-04 Installed by: DAVID YOUNTZ

Improvement Permit by: STEVE HEDRICK date 8-23-04 Operation Permit by: STEVE HEDRICK date 9-5-05

Authorization to Construct by: STEVE HEDRICK date 8-23-04 Existing System Inspection by: ____ date ____

HEALTH DEPT. COPY: WHITE OWNER COPY (FINAL): YELLOW OWNER COPY (INITIAL): PINK