2130 THIS PERMIT VOIDS PREVIOUS ISSUED 2-20-96 22881

IREDELL COUNTY HEALTH DEPARTMENT

STATESVILLE 704-878-5305 MOORESVILLE 704-664-5281

IMPROVEMENT PERMIT / CERTIFICATE OF COMPLETION / OPERATION PERMIT / EXISTING SYSTEM INSPECTION

PROPERTY DESCRIPTION NO. 23287 DATE 3-13-96 TAX MAP NO 11 M-A-54 Watershed: Yes ✓ No

OWNER OR CONTRACTOR CORY JOHNSON PHONE: Business Home 873-1932

ADDRESS 148 BARRY OAK ROAD, STATESVILLE NC 28677

LOCATION OLD MOCKSVILLE ROAD NE, TR JEFFERSON FARM ROAD, ~ 0.2 MILE ON RIGHT

SUBDIVISION BLOCK / SECTION LOT LOT AREA 7 ACRES SITE CLASS PS DESIGN FLOW 360 LTAR 0.3 GPD/FT

Septic Tank: 1000 Gallons: STB 1012 Date 12-24-95
Pump Tank. Gallons: PT Date
Pump Make Model Serial No
Nitrification Field No Fields 1 Square Feet 1200 Linear Feet 400
No Lines 4 Trench Width 36" Max Trench Bottom Depth 18-36" Gravel Depth 12"

✓ New System Repair System Type I II III IV V VI
System Description: CONVENTIONAL GRAVITY
Repair System Description CONV. GRAVITY
Maintenance Agreement Required: Yes ✓ No

✓ House/Mod. Home No Bedrooms 3
Mobile Home No Bathrooms 2
Business No Employees
Other FUTURE 3BR HOUSE


Slab ✓ Crawl Space Basement w/plumbing Basement wo/plumbing

Water Supply: ✓ Individual Community Public WELL


Comments ① USE FLOW DIVIDER TEES (THREE) TO ACHIEVE EQUAL DISTRIBUTION INTO EACH OF FOUR 100' LINES ② INSTALL LINES AS SHOWN NO DEEPER THAN 36", 9' ON CENTER ③ KEEP WELL 100' FROM SYSTEM

Comments Well Not on site at time of this inspection Keep 100' from S.T. System.

INITIAL SITE SKETCH

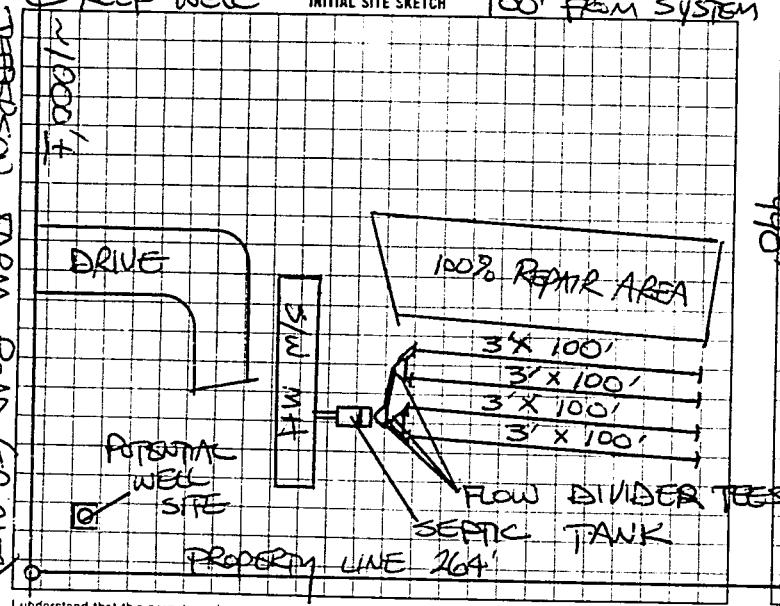

AS BUILT SKETCH

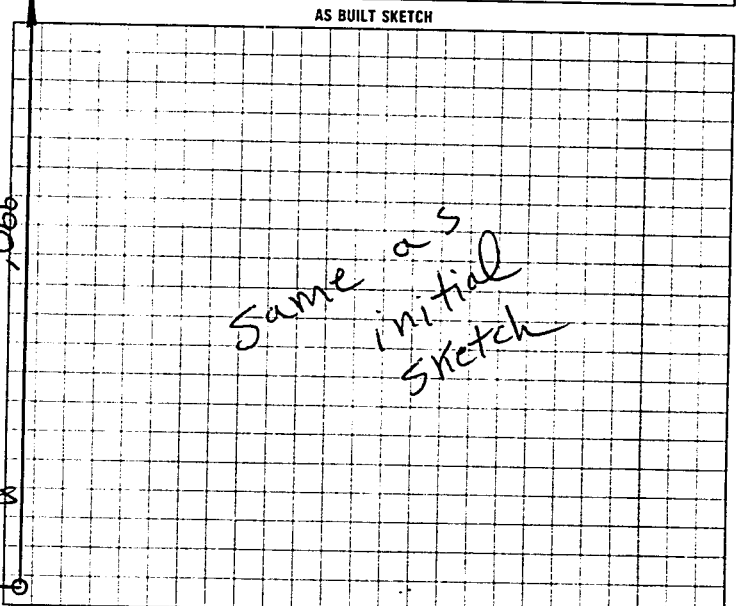

I understand that this permit can be suspended or revoked if any false information is supplied toward securing the permit/any unauthorized changes are made to the site/any unauthorized changes are made in the installation of the system

AUTHORIZATION TO CONSTRUCT IS VALID FIVE (5) YEARS FROM DATE OF ISSUANCE. IMPROVEMENT PERMIT HAS NO EXPIRATION DATE.

Signed ✗ Robert Cory Johnson

Improvement Permit by STEVE HEDACK date 3-13-96

AUTHORIZATION TO CONSTRUCT

Existing System Inspection by STEVE HEDACK date 3-13-96

Installed by Baynes Const. Co.

Certificate of Completion by date

Operation Permit by F. C. Moore date 3-22-96

HEALTH DEPT COPY WHITE INSPECTION COPY (FINAL) GREEN OWNER COPY (FINAL) YELLOW INSPECTION COPY (INITIAL) PINK OWNER COPY (INITIAL)

2860000