IREDELL COUNTY HEALTH DEPARTMENT

STATESVILLE 704-878-5305 MOORESVILLE 704-664-5281

IMPROVEMENT PERMIT / AUTHORIZATION TO CONSTRUCT / OPERATION PERMIT / EXISTING SYSTEM INSPECTION

C1

PERMIT# 136521 PIN# 4776-79-6031 DATE 4-16-04

OWNER OR APPLICANT Allan Lewis General Contr PHONE: Business 704 871 7896 Home

ADDRESS 118 New Hope Rd Statesville NC

LOCATION 21 N to Dunlop Gate (L) Old Mocksville (R) Church Lake (R) Stone Creek 1st on Left

SUBDIVISION Stonecreek BLOCK / SECTION LOT 16 LOT AREA .978 SITE CLASS. PS DESIGN FLOW 360 L.T.A.R. .25

Septic Tank: 1000 Gallons; STB 102 Date 9-8-04

Pump Tank: Gallons; PT Date

Pump Make: Model Serial No.

Nitrification Field: No Fields Square Feet 1440 Linear Feet 360

No Lines 4 Trench Width 24" Max Trench Bottom Depth 36" Gravel Depth N/A

☐ New System ☐ Repair ☐ Expansion System Type: I (II) III IV V VI

System Description: 25% Gravity

Repair System Description: Low Pres. Pump

Maintenance Agreement Required: ☐ Yes ☐ No

☑ House/Mod. Home ☐ Mobile Home ☐ Business ☐ Other


No. Bedrooms 3 No. Persons No. Employees

Water Supply: ☐ Individual ☑ Public ☐ Community

☑ Gravity ☐ Pressure ☐ Slab ☐ Crawl Space ☐ Basement w/plumbing ☐ Basement wo/plumbing

Comments:/Conditions:


INITIAL SITE SKETCH

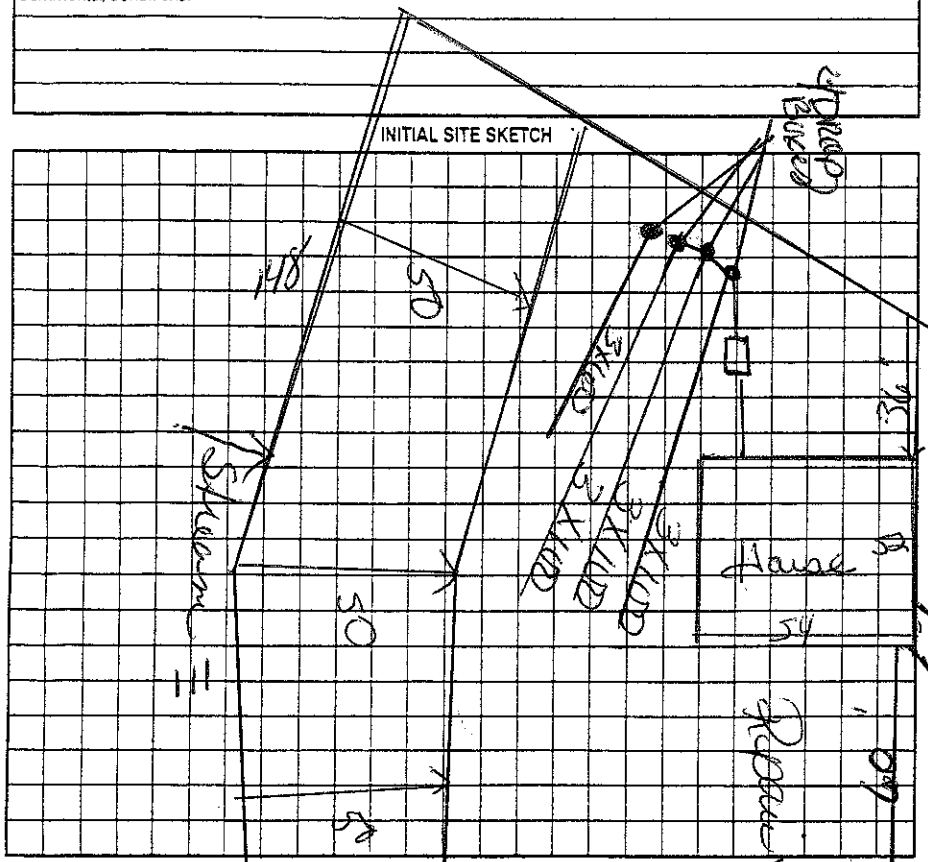

Comments:/Conditions:

Install on Contour
Maintain all setbacks
Yellow Lot

AS BUILT SKETCH

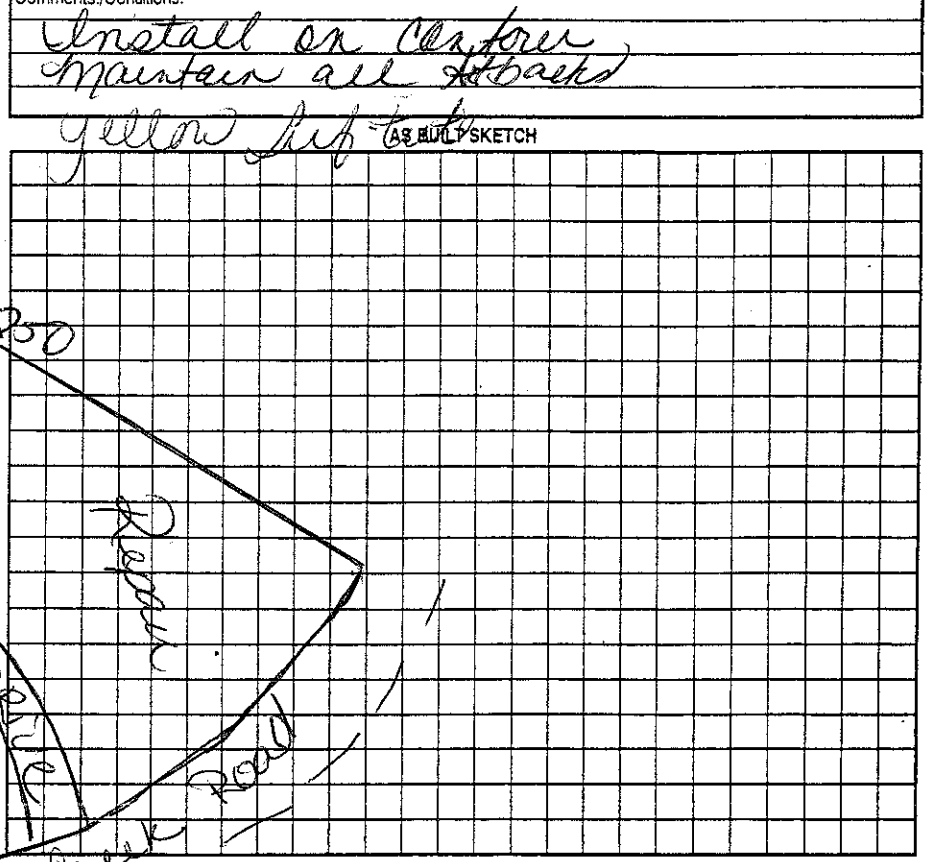

Permit can be suspended or revoked if any false information is supplied toward securing the permit/any unauthorized changes are made to the site/any unauthorized changes are made in the installation of the system. Improvement Permit with plat valid without expiration ☐ Improvement Permit with site plan valid for sixty months ☐ Authorization to Construct is valid for a period equal to that of Improvement Permit – not to exceed sixty months.

Signed: Allan Lewis date 5-25-04 Installed by: DAVID GOYNTZ

Improvement Permit by: Rusty Cook date 4-16-04 Operation Permit by: Rusty Cook date 3-8-07

Authorization to Construct by: Rusty Cook date 4-16-04 Existing System Inspection by: date

HEALTH DEPT. COPY: WHITE OWNER COPY (FINAL): YELLOW OWNER COPY (INITIAL): PINK