CI

IREDELL COUNTY HEALTH DEPARTMENT

STATESVILLE 704-878-5305 MOORESVILLE 704-664-5281

IMPROVEMENT PERMIT / AUTHORIZATION TO CONSTRUCT / OPERATION PERMIT / EXISTING SYSTEM INSPECTION

PERMIT# 094471 PIN# 4767 66 6287 DATE 5-4-01

OWNER OR CONTRACTOR BOBBY ANDERSON PHONE: Business (704)546-2273 Home CELL 902-4576

ADDRESS 239 KINDER RD., HARMONY, N.C. 28634

LOCATION HWY 21 (R) CHURCH LAKE RD 3.4 mi (L) STONE CREEK TO LOT ON RT

SUBDIVISION STONECREEK BLOCK / SECTION ____ LOT 9 LOT AREA .83 AC SITE CLASS PS DESIGN FLOW 360 GPD L.T.A.R. .3

Septic Tank: 1000 Gallons; STB 1012 Date 8-26-01
Pump Tank: ____ Gallons; PT ____ Date ____
Pump Make: ____ Model ____ Serial No. ____
Nitrification Field: No Fields 1 Square Feet 1200' Linear Feet 300'
No Lines 4 Trench Width 36" Max Trench Bottom Depth 36"

[X] New System [ ] Repair System Type: I. II. III. IV. V. VI
System Description: GRAV 25% REDUCTION
Repair System Description: PUMP/GRAV 25% REDUCTION
Maintenance Agreement Required: [ ] Yes [X] No
Gravel Depth N/A [ ] Slab [X] Crawl Space [ ] Basement w/plumbing [ ] Basement wo/plumbing


[X] House/Mod. Home No. Bedrooms 3
[ ] Mobile Home No. Bathrooms 2
[ ] Business No. Employees ____
[ ] Other ____

Water Supply: [ ] Individual [X] Public [ ] Community

Comments/Conditions: (1) AREA OF DRAINFIELD NOT FULLY CLEARED CALL PRIOR TO INSTALLATION FOR COMPLETE FLAGOUT (2) INSTALL LINES ON CONTOUR (3) MAINTAIN SET BACKS (4) USE 4 DROP BOXES

Comments/Conditions: POLYLOK FITTER & MARKER INSTALLED AS SHOWN

INITIAL SITE SKETCH

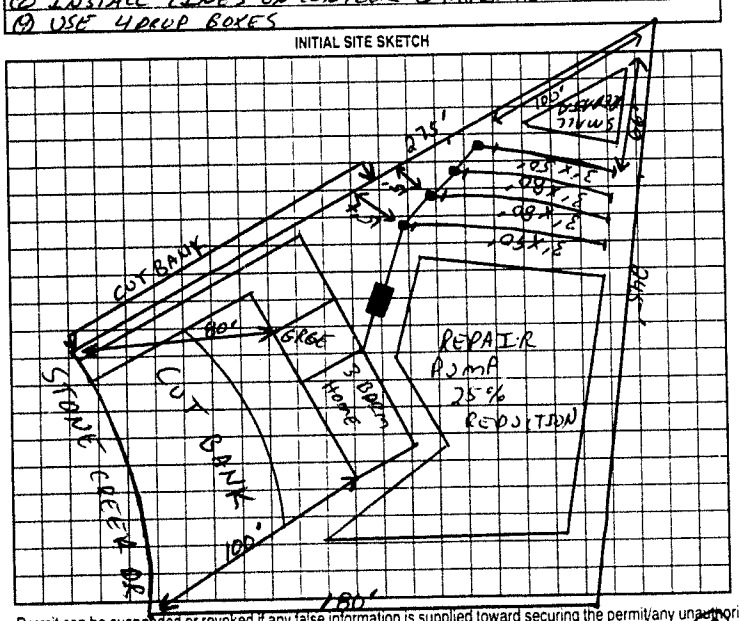

AS BUILT SKETCH

Permit can be suspended or revoked if any false information is supplied toward securing the permit/any unauthorized changes are made to the site/any unauthorized changes are made in the installation of the system. Improvement Permit with plat valid without expiration. Improvement Permit with site plan valid for sixty months. Authorization to Construct is valid for a period equal to that of Improvement Permit – not to exceed sixty months.

Signed: Bobby Anderson date 8-28-01

Improvement Permit by: Jim Cook RSI date 5-4-01

Authorization to Construct by: Jim Cook RSI date 5-4-01

Installed by: Tommy Page date 8-30-01

Operation Permit by: Jim Cook RS date 12-7-01

Existing System Inspection by: ____ date ____

HEALTH DEPT. COPY: WHITE OWNER COPY (FINAL): YELLOW OWNER COPY (INITIAL): PINK