IREDELL COUNTY HEALTH DEPARTMENT

STATESVILLE 704-878-5305 MOORESVILLE 704-664-5281

IMPROVEMENT PERMIT / AUTHORIZATION TO CONSTRUCT / OPERATION PERMIT / EXISTING SYSTEM INSPECTION

PERMIT# 91611 PIN# 4767666287 DATE 8-30-00

OWNER OR CONTRACTOR Bobby Anderson PHONE: Business Home 546 2273

ADDRESS 239 Hinkey Rd Harmony N.C.

LOCATION Old Mocksville Th Church Lake TR stonecreek 1/4mi Rt.

SUBDIVISION stonecreek BLOCK / SECTION LOT 10 LOT AREA .8 acre SITE CLASS PS DESIGN FLOW 360 L.T.A.R. .13gal/sq ft/day

Septic Tank: 1000 Gallons; STB 1012 Date 9-4-00
Pump Tank: Gallons; PT Date
Pump Make: Model Serial No.
Nitrification Field: No Fields 1 Square Feet 1200 Linear Feet 400
No Lines 4 Trench Width 36" Max Trench Bottom Depth 36" Gravel Depth 12"

☑ New System ☐ Repair System Type: ☐ I ☐ II, IV, V, VI
System Description: Conv. Gravity
Repair System Description: Gravity 75% Red.
Maintenance Agreement Required: ☐ Yes ☑ No

☑ House/Mod. Home ☐ Mobile Home ☐ Business ☐ Other
No. Bedrooms 3 No. Bathrooms 2 No. Employees


☐ Slab ☐ Crawl Space ☐ Basement w/plumbing ☐ Basement wo/plumbing

Water Supply: ☐ Individual ☑ Public ☐ Community


Comments/Conditions:

Comments/Conditions: SEPTIC TANK W/ RISERS & MARKER INSTALLED USING "POLYLOK" FILTER

INITIAL SITE SKETCH

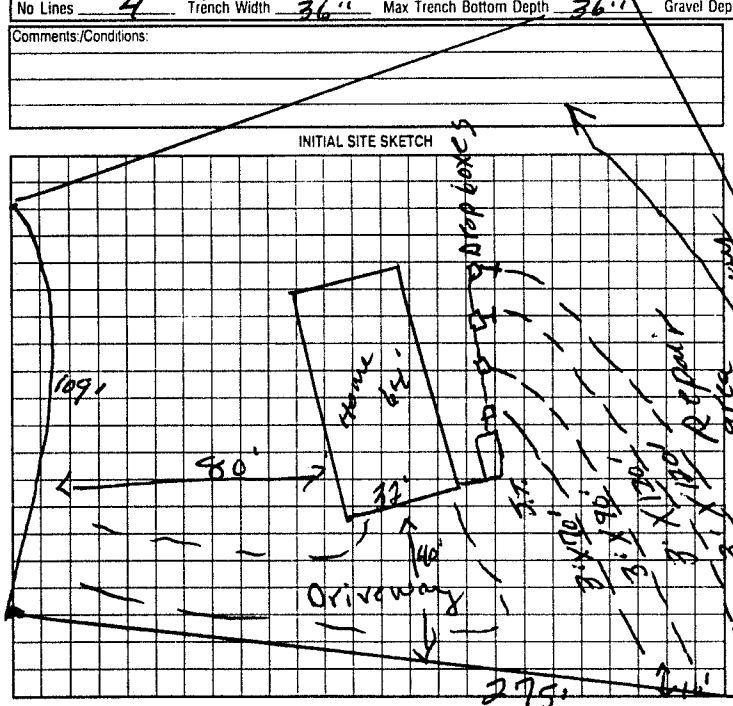

AS BUILT SKETCH

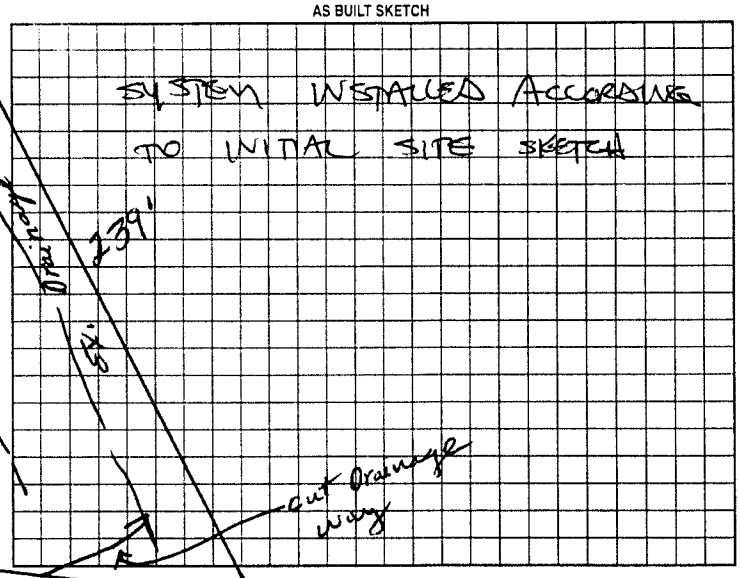

Permit can be suspended or revoked if any false information is supplied toward securing the permit/any unauthorized changes are made to the site/any unauthorized changes are made in the installation of the system. Improvement Permit with plat valid without expiration. Improvement Permit with site plan valid for sixty months. Authorization to Construct is valid for a period equal to that of Improvement Permit – not to exceed sixty months.

Signed: [signature] date Installed by: DAVID YOUNTS

Improvement Permit by: J.C. Moore date 8-30-00 Operation Permit by: STEVE HEDRICK date 12-1-00

Authorization to Construct by: J.C. Moore date 8-30-00 Existing System Inspection by: date

HEALTH DEPT. COPY: WHITE OWNER COPY (FINAL): YELLOW OWNER COPY (INITIAL): PINK