CI

IREDELL COUNTY HEALTH DEPARTMENT

STATESVILLE 704-878-5305 MOORESVILLE 704-664-5281

IMPROVEMENT PERMIT / AUTHORIZATION TO CONSTRUCT / OPERATION PERMIT / EXISTING SYSTEM INSPECTION

PERMIT# 10618 PIN# 4767-76-3532 DATE 06-08-02

OWNER OR CONTRACTOR ALAN LEWIS PHONE: Business Home 704-878-2305

ADDRESS 118 NEW HOPE RD STATESVILLE NC 28625

LOCATION OLD MOCKSVILLE RD, (L) CHURCH'S LAKE, (R) STONE CREEK, AT END ON RT AT LOT # 11

SUBDIVISION STONE CREEK BLOCK / SECTION LOT 11 LOT AREA 0.800 AC SITE CLASS PS DESIGN FLOW 360 L.T.A.R. .3

Septic Tank: 1000 Gallons; STB 1012 Date 9-9-02
Pump Tank: Gallons; PT Date
Pump Make: Model Serial No.
Nitrification Field: No Fields 1 Square Feet EQ=1200 Linear Feet 300'
No Lines 4x75' Trench Width 36" Max Trench Bottom Depth 36" Gravel Depth N/A

☐ New System ☐ Repair System Type: I, II, (III) IV, V, VI
System Description: GRAV 25% RED
Repair System Description: LP PANEL
Maintenance Agreement Required: ☐ Yes ☒ No


☒ House/Mod. Home No. Bedrooms 3
☐ Mobile Home No. Bathrooms 2
☐ Business No. Employees
☐ Other
☐ Slab ☐ Crawl Space ☐ Basement w/plumbing ☐ Basement wo/plumbing

Water Supply: ☐ Individual ☒ Public ☐ Community


Comments:/Conditions: (1) STUB OUT 6" ABOVE NATURAL GRADE & BACKFILL (2) TANK CAN BE MOVED / ROTATED IF DESIRED, JUST MAINTAIN 15' SIDESLOPE SETBACKS OFF BASEMENT FOUNDATION DRAIN WITH ANY PART OF SYSTEM (3) INSTALL

Comments:/Conditions: LINES ON CONTOURS (4) MAINTAIN SETBACKS TUFFTITE FILTER & MARKER

INITIAL SITE SKETCH

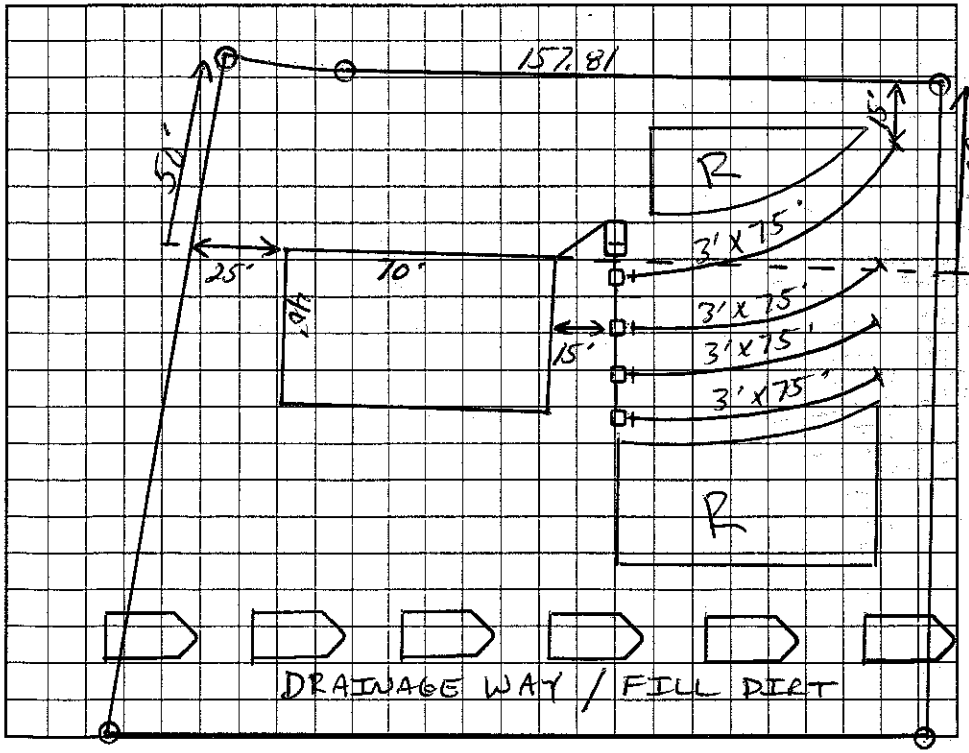

AS BUILT SKETCH

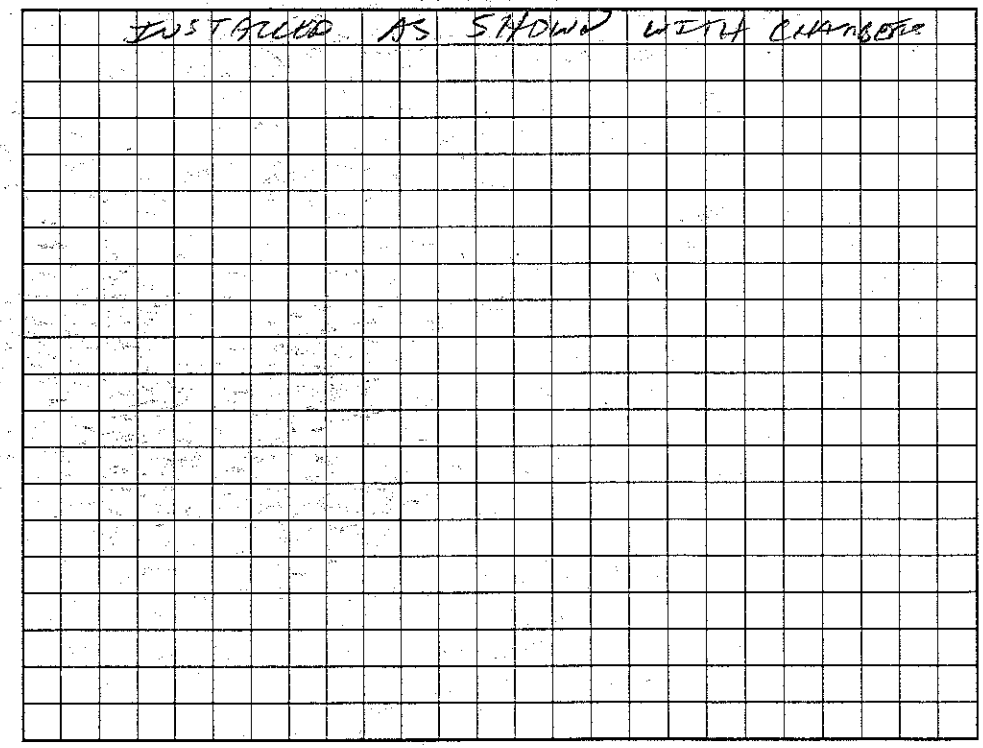

Permit can be suspended or revoked if any false information is supplied toward securing the permit/any unauthorized changes are made to the site/any unauthorized changes are made in the installation of the system. Improvement Permit with plat valid without expiration. Improvement Permit with site plan valid for sixty months. Authorization to Construct is valid for a period equal to that of Improvement Permit – not to exceed sixty months.

Signed: Alan Lewis date Sept 11-02 Installed by: DAVID YOUNTZ

Improvement Permit by: date 06-10-02 Operation Permit by: date 4-29-03

Authorization to Construct by: date 06-10-02 Existing System Inspection by: date

HEALTH DEPT. COPY: WHITE OWNER COPY (FINAL): YELLOW OWNER COPY (INITIAL): PINK