IREDELL COUNTY HEALTH DEPARTMENT

STATESVILLE 704-878-5305 MOORESVILLE 704-664-5281

CI/CI

IMPROVEMENT PERMIT / AUTHORIZATION TO CONSTRUCT / OPERATION PERMIT / EXISTING SYSTEM INSPECTION

PERMIT# 10708F PIN# 4767-76-3754 DATE 10-26-02

OWNER OR CONTRACTOR BOBBY ANDERSON PHONE: Business 704-902-4576 Home 704-546-2273

ADDRESS 239 KINDER ROAD HARMONY, NC 28634

LOCATION 21 N, (R) DUNLAP GATE (L) OMR, (L) CHURCH'S LAKE, (R) STONE CREEK, ATENDON RT LOT # 12

SUBDIVISION STONECREEK BLOCK / SECTION ____ LOT 12 LOT AREA 1.073 AC SITE CLASS. ____ DESIGN FLOW 360 L.T.A.R. .35

Septic Tank: 1000 Gallons; STB 1012 Date 12-20-02
Pump Tank: ____ Gallons; PT ____ Date ____
Pump Make: ____ Model ____ Serial No. ____
Nitrification Field: No Fields 1 Square Feet 1028 Linear Feet 343'
No Lines 4 Trench Width 36" Max Trench Bottom Depth 36" Gravel Depth 12"

[X] New System [ ] Repair System Type: I, II, III, IV, V, VI
System Description: CONV GRAV
Repair System Description: GRAV 25% REDUCT
Maintenance Agreement Required: [ ] Yes [X] No


[X] House/Mod. Home No. Bedrooms 3
[ ] Mobile Home No. Bathrooms 2
[ ] Business No. Employees ____
[ ] Other ____
[ ] Slab [ ] Crawl Space [ ] Basement w/plumbing [X] Basement wo/plumbing

Water Supply: [ ] Individual [X] Public [ ] Community

Comments/Conditions: (1) STUBOUT ABOVE NATURAL GRADE TO MAINTAIN FALL TO TANK. AT LEAST 15" AND BACKFILL. (2) RUN SURFACE H2O FROM DITCH DOWN PROPERTY LINE

Comments/Conditions: (3) INSTALL LINES ON CONTURE (4) MAINTAIN SETBACKS (5) HAVE SIDE PROPERTY LINE MARKED BY INSTALLATION. TUFF TIRE FILTER & MARKER, INSTALLED AS DRAWN

INITIAL SITE SKETCH

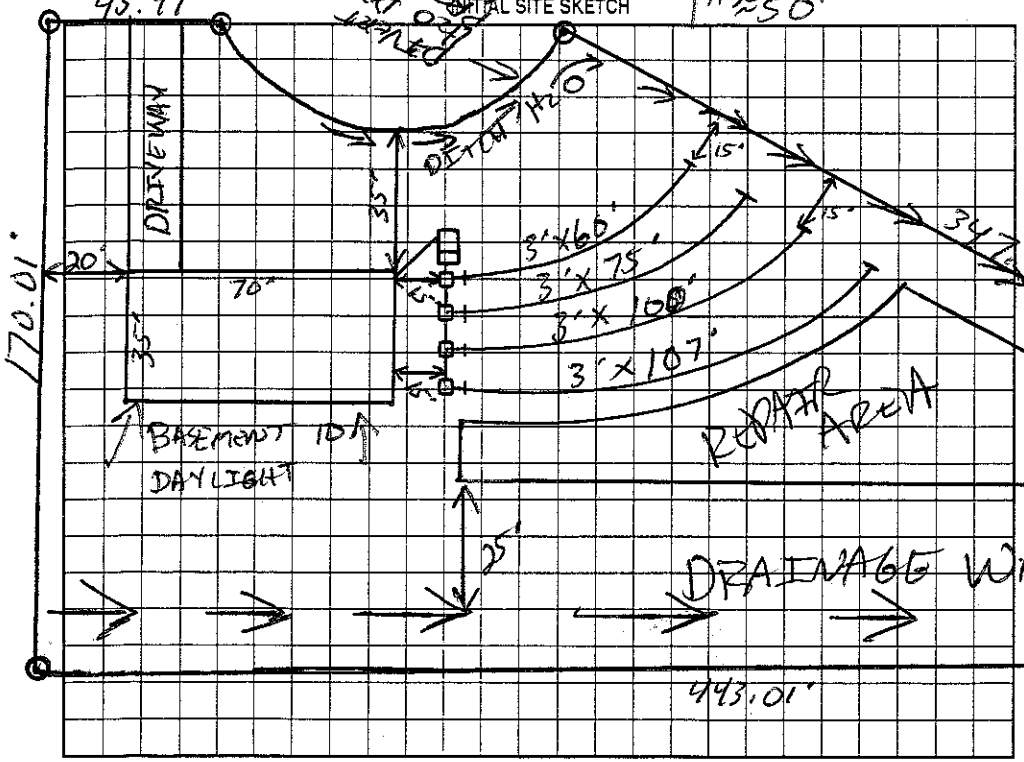

1" ≈ 50'

AS BUILT SKETCH

(*) DO NOT CUT OFF ANY SOIL THAT'S IN THE DRAIN LINE AREA. THE DRAIN LINES WERE CHECKED & HAD 12" OF COVER ON THE LOW SIDE. LINES ARE ON A 20% SLOPE SO REMOVING SOIL DUE TO LANDSCAPING COULD (*) TAKE PLACE VERY EASILY, BUT DO NOT ALLOW. SURFACE DIVERSION DITCH WAS 15' AS DRAWN AT TIME OF CHECK.

Permit can be suspended or revoked if any false information is supplied toward securing the permit/any unauthorized changes are made to the site/any unauthorized changes are made in the installation of the system. Improvement Permit with plat valid without expiration. Improvement Permit with site plan valid for sixty months. Authorization to Construct is valid for a period equal to that of Improvement Permit – not to exceed sixty months.

Signed: Bobby Anderson date 10-25-02 Installed by: TOMMY FRYE

Improvement Permit by: ____ date 10-26-02 Operation Permit by: ____ date 7-9-03

Authorization to Construct by: ____ date 10-26-02 Existing System Inspection by: ____ date ____

HEALTH DEPT. COPY: WHITE OWNER COPY (FINAL): YELLOW OWNER COPY (INITIAL): PINK