ICHD - ENVIRONMENTAL HEALTH DIVISION

Statesville Office (704) 878-5305 (BB) Mooresville Office (704) 660-3625 PERMIT # 311255

SEPTIC: IMPROVEMENT PERMIT / AUTHORIZATION TO CONSTRUCT / OPERATION PERMIT / EXISTING SYSTEM

PIN # 4768-46-4284

APPLICANT/OWNER: Angie Love APPLICANT ADDRESS: 308 Church lake Rd Statesville 28625

SITE ADDRESS: 308 Church lake Road Statesville NC 28625 PHONE: 704-902-8155 ALT. PHONE 704-902-9295

SITE DIRECTIONS: I-77N Exit Hwy 21 North 7 mi bs R on Church Lake house on R SAP CONTROLLED: ☐ YES ☒ NO

SUBDIVISION: - SECTION: - LOT # - LOT AREA: 2 Acre DESIGN FLOW: 360 gpd L.T.A.R.: 3

Septic Tank	Existing	(gal)	STB		Date						
Pump Tank		(gal)	PT		Date						
Pump Make			Model		Serial #						
# Nitrification Fields	1		# Lines	1	Linear Ft	100'					
Trench Width	36"		Trench Bottom Depth (~~Low side~~)		Max 36"		Gravel Depth	-			

☐ New System ☐ Repair ☒ Expansion System Type: I II (III) IV V VI

System Description: 25% Reduction

Repair System Description: 25% Reduction

Maintenance Agreement Required: ☐ YES ☒ NO

☒ GRAVITY ☐ PRESSURE


☒ Residence ☐ Business ☐ Other ☐ Slab ☒ Basement w/plumbing

No. Bedrooms Ex No. Persons Ex No. Employees ☐ Crawl Space ☐ Basement w/o plumbing

Water Supply: ☒ Private ☐ Public ☐ Community

Comments / Conditions: Purpose of this permit is to Abandon top Septic line to meet Setbacks for pool. Add 100' line to bottom of septic area to replace abandons line.

INITIAL SITE SKETCH

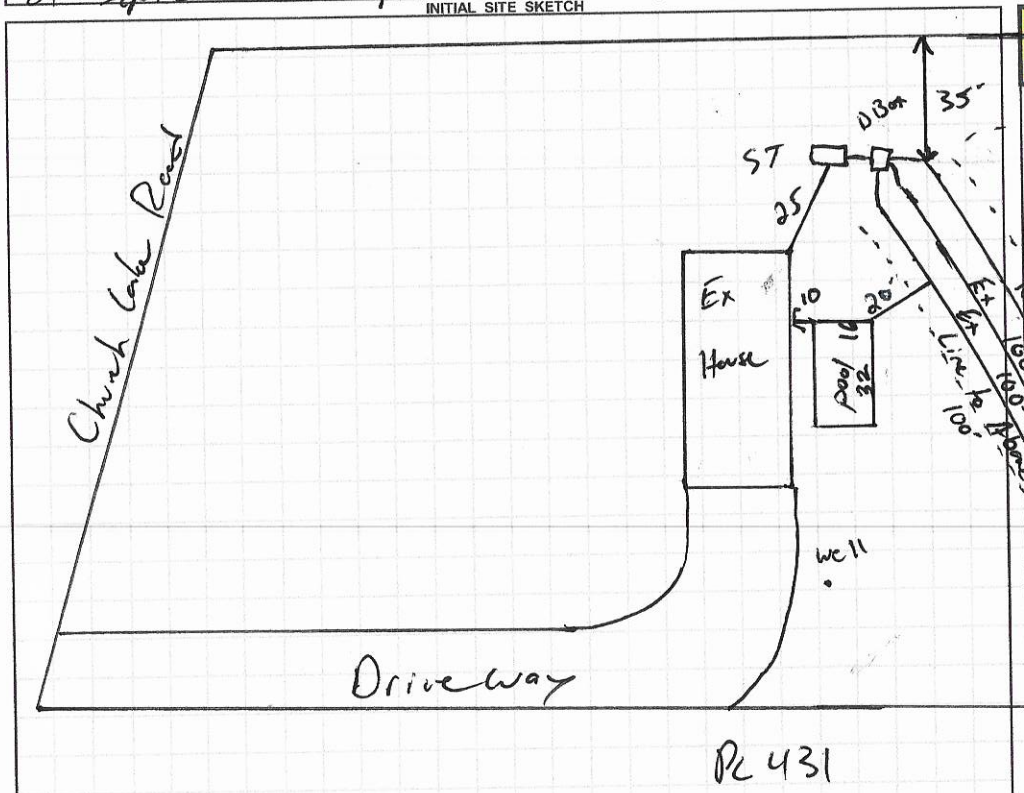

AS BUILT SKETCH

FOR SEPTIC FINAL INSPECTION CALL: 704-664-3703 between 8am-9am the day the inspection is needed. Be sure to speak with an inspector to confirm your time.

Permit can be suspended or revoked if any false information is supplied toward securing the permit / any unauthorized changes are made to the site / any unauthorized changes are made in the installation of the system. **CONTACT A LOCATOR SERVICE PRIOR TO ANY EXCAVATION**

☐ **IMPROVEMENT PERMIT** *with plat valid without expiration.* ☐ **IMPROVEMENT PERMIT** *with site plan valid for 60 mos.* ☑ **AUTHORIZATION TO CONSTRUCT** *valid for period equal to IMPROVEMENT PERMIT--not to exceed 60 mo.*

Owner / Applicant Signature: Date: 11-03-20 Installed by: Rick Al Beckham

IMPROVEMENT PERMIT by: Date: 11-17-2020 OPERATION PERMIT by: Date: 12.29.2020

AUTHORIZATION TO CONSTRUCT by: Date: 11-17-2020 Existing System Inspected by: Date:

FOR SEPTIC FINAL INSPECTION: CALL 704-664-3703 between 8am-9am the day the inspection is needed.

DEPARTMENT OF HEALTH AND HUMAN SERVICES
DIVISION OF PUBLIC HEALTH, ENVIRONMENTAL HEALTH SECTION
ON-SITE WATER PROTECTION BRANCH

Sheet 1 of 1
PROPERTY ID #:
COUNTY: Iredell

SOIL/SITE EVALUATION
for ON-SITE WASTEWATER SYSTEM
(Complete all fields in full)

OWNER: Angie Lowe
ADDRESS: 308 Church Lake Road
PROPOSED FACILITY: Pool
PROPOSED DESIGN FLOW (.1949): 360gpd
LOCATION OF SITE: 308 Church Lake
APPLICATION DATE 9-21-2020
DATE EVALUATED: 11-16-2020
PROPERTY SIZE: 2 Acres
PROPERTY RECORDED: Yes

WATER SUPPLY: ☐ Private ☐ Public ☑ Well ☐ Spring ☐ Other
EVALUATION METHOD: ☐ Auger Boring ☑ Pit ☐ Cut
TYPE OF WASTEWATER: ☑ Sewage ☐ Industrial Process ☐ Mixed

PROFILE #	.1940 LANDSCAPE POSITION/ SLOPE %	HORIZON DEPTH (IN.)	SOIL MORPHOLOGY (.1941) .1941 STRUCTURE/ TEXTURE	.1941 CONSISTENCE/ MINERALOGY	OTHER PROFILE FACTORS .1942 SOIL WETNESS/ COLOR	.1943 SOIL DEPTH	.1956 SAPRO CLASS	.1944 RESTR HORIZ	PROFILE CLASS & LTAR
1	4-5%	0-6	SBK SCL	Fr SSSP Sap					
		6-32	SBK C						
		32-48	SBK CL						
					N/A	48+	N/A	N/A	AS .3
2	4-5%	0-6	SBK SCL						
		6-30	SBK C						
		30-48	SBK CL						
					N/A	48+	N/A	N/A	AS .3
3	4-5%	0-6	SBK SCL						
		6-28	SBK C						
		28-48	SBK CL						
					N/A	48+	N/A	N/A	PS .3
4	4-5%	0-6	SBK SCL						
		6-28	SBK C						
		28-48	SBK CL						
					N/A	48+	N/A	N/A	PS .3

DESCRIPTION	INITIAL SYSTEM	REPAIR SYSTEM
Available Space (.1945)	300'	300'
System Type(s)	25%	25%
Site LTAR	.3	.3

OTHER FACTORS (.1946):
SITE CLASSIFICATION (.1948):
EVALUATED BY:
OTHER(S) PRESENT:

COMMENTS:

LEGEND

use the following standard abbreviations

LANDSCAPE POSITION	GROUP	SOIL TEXTURE	CONVENTIONAL .1955 LTAR*	LPP .1957 LTAR*	MINERALOGY/ CONSISTENCE	STRUCTURE
CC (Concave Slope) CV (Convex Slope) D (Drainage Way) DS (Debris Slump) FP (Flood Plain) FS (Foot Slope) H (Head Slope) L (Linear Slope) N (Nose Slope) R (Ridge) S (Shoulder Slope) T (Terrace)	I	S (Sand) LS (Loamy Sand)	1.2 - 0.8	0.6 - 0.4	SEXP (Slightly Expansive) EXP (Expansive)	G (Single Grain) M (Massive) CR (Crumb) GR (Granular) SBK (Subangular Blocky) ABK (Angular Blocky) PL (Platy) PR (Prismatic)
	II	SL (Sandy Loam) L (Loam)	0.8 - 0.6	0.4 - 0.3		
	III	Si (Silt) SiCL (Silty Clay Loam) CL (Clay Loam) SCL (Sandy Clay Loam) SiL (Silt Loam)	0.6 - 0.3	0.3 - 0.15		
					MOIST	**WET**
	IV	SC (Sandy Clay) SiC (Silty Clay) C (Clay)	0.4 - 0.1	0.2 - 0.05	VFR (Very Friable) FR (Friable) FI (Firm) VFI (Very Firm v. Very Sticky)	NS (Non-sticky) SS (Slightly Sticky) S (Sticky) VS (Very Sticky)
		O (Organic)	None	None	EFI (Extremely Firm)	NP (Non-plastic) SP (Slightly Plastic) P (Plastic) VP (Very Plastic)

*Adjust LTAR due to depth, consistence, structure, soil wetness, landscape, position, wastewater flow and quality.


NOTES

HORIZON DEPTH	In inches below natural soil surface
DEPTH OF FILL	In inches from land surface
RESTRICTIVE HORIZON	Thickness and depth from land surface
SAPROLITE	S(suitable) or U(unsuitable)
SOIL WETNESS	Inches from land surface to free water or inches from land surface to soil colors with chroma 2 or less - record Munsell color chip designation
CLASSIFICATION	S (Suitable), PS (Provisionally Suitable), or U (Unsuitable)

Evaluation of saprolite shall be by pits.

Long-term Acceptance Rate (LTAR): gal/day/ft²

Show profile locations and other site features (dimensions, reference or benchmark, and North).

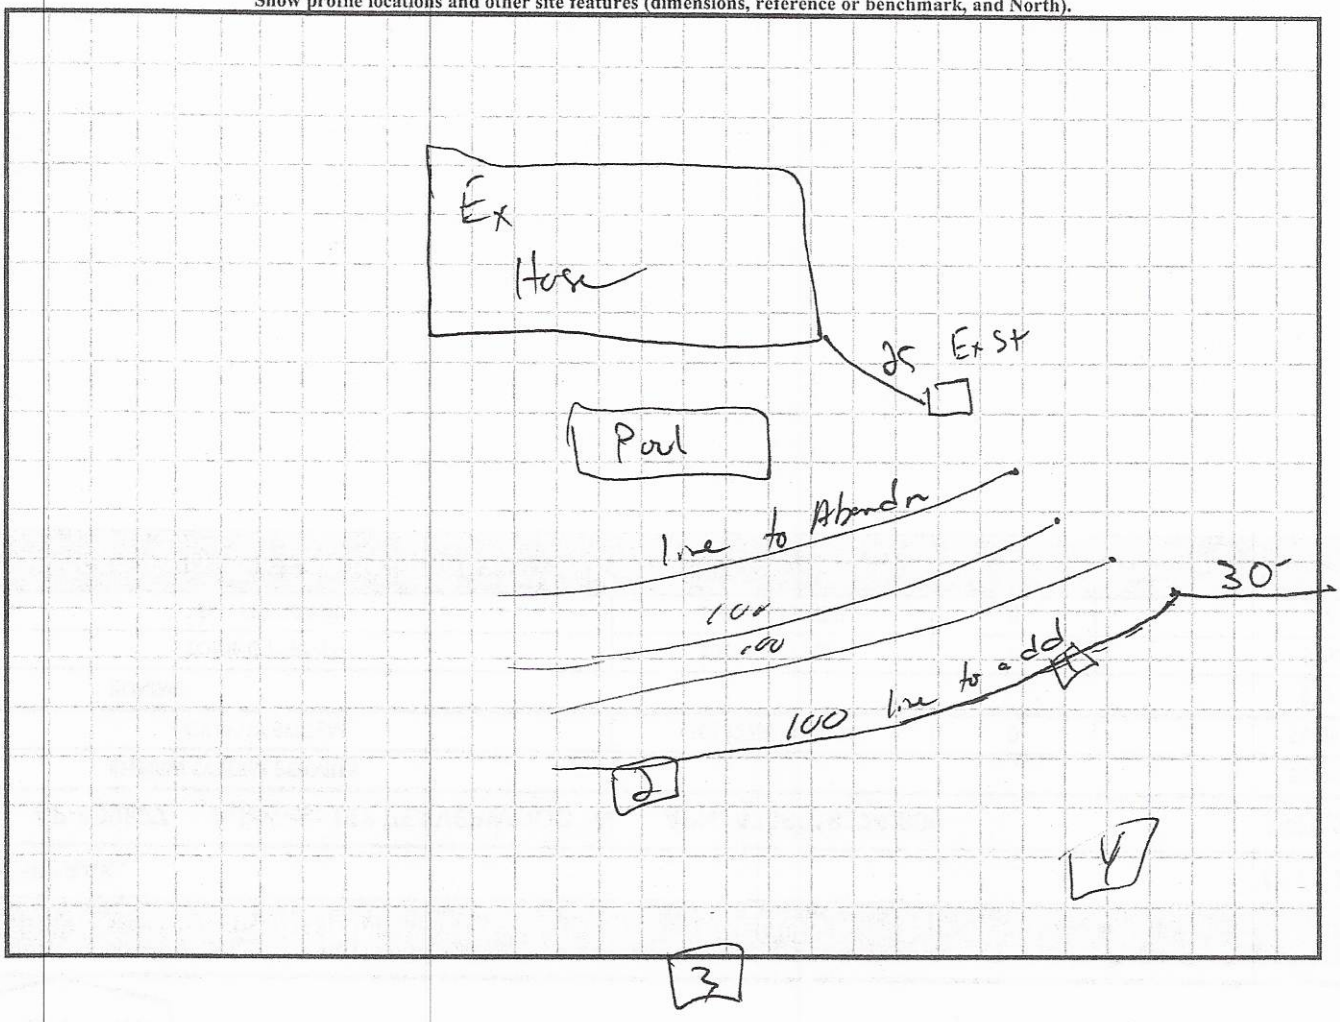

RECEIVED SEP 2 8 2020 AP-311255 $500.00

APPLICATION MUST BE FILLED OUT COMPLETELY & BE LEGIBLE OR IT WILL NOT BE PROCESSED

Iredell County Health Department – Environmental Health Division

PAGE 1: *APPLICATION FORM*

Relocation

Application For: ( ) New Well Permit ( ) Well Repair Permit ( ) Well Abandonment
(✓) Septic Improvement Permit (✓) Authorization to Construct (✓) Existing System Inspection ( ) Septic System Repair

THE ABOVE PERMIT DOCUMENTS WILL BECOME INVALID IF INFORMATION PROVIDED ON THIS APPLICATION IS FALSIFIED OR CHANGED, OR IF THE SITE IS ALTERED. THE IMPROVEMENT PERMIT IS VALID FOR EITHER 60 MONTHS OR WITHOUT EXPIRATION DEPENDING UPON DOCUMENTATION SUBMITTED. APPLICATION WITH SITE PLAN 60 MONTHS. APPLICATION WITH COMPLETE. SCALED PLAT WITHOUT EXPIRATION. SEE 15A NCAC 18A .1937(f) FOR DETAILS.

Page 2: *Site Plan Worksheet* form MUST accompany this application

The following optional attachments may also be submitted: ( ) Survey Plat, scaled no more than 1 inch = 60 feet
Place an (X) beside whichever is submitted if applicable ( ) Custom Site Plan, scaled no more than 1 inch = 60 feet

Applicant Information: (PRINT CLEARLY)

Applicant Name: Angie Love **Address:** 308 Church Lake Rd. Statesville, NC **Zip:** 28625
Applicant Email: amlove8155@gmail.com **Phone:** 704-902-8155 **Alt. Phone:** 704-902-9295
Owner Name: Larry Keith Love & Sherry Angela Love **Address:** 308 Church Lake Rd. Statesville, NC **Zip:** 28625
Owner Email: amlove8155@gmail.com **Phone:** *704-902-8155 **Alt. Phone:** 704-902-9295

Property Information:

Street Address: 308 Church Lake Rd. Statesville, NC 28625

Subdivision Name: _____ **Section/Phase:** _____ **Lot Number:** _____

Driving Directions: I-77 Exit Turnersburg Hwy (21), North 7 miles, Right on Church Lake Rd, house 1/2 mile on right

Site Development Information: ***(check or complete ALL that apply***

CHECK FOUNDATION TYPE

( ) New Single Family Residence — Maximum Number of Bedrooms: 3 — ( ) Crawl Space Foundation
( ) New Multi-Family Residence — Maximum Number of Occupants: 2 — ( ) Concrete Slab Foundation
( ) Accessory Building — (✓) Swimming Pool — (✓) Basement with Plumbing
( ) Bedroom(s) Addition — ( ) Other Addition/Structure: _____ — ( ) Basement without Plumbing
( ) Repair to failing septic system ___ Tank ___ Drain lines Describe Problem: _____
Non-Residential Site Development: Type of Business: _____
Square Footage of Building: _____ Max. Number of Employees: _____ Max. Number of Seats/Beds/Other: _____

Water Supply: ( ) Replacement Well – Reason: _____
( ) Multi-connection Well Number of Houses: _____ Number of Persons: _____

( ) New Well ( ) Existing Well ( ) Community Well ( ) City Water ( ) Other Public Water

Desired Septic System Type: ***(you may rank in order of preference)*** Year existing system installed: 1990
(✓) No Preference ( ) Alternative ( ) Conventional ( ) Innovative ( ) Modified Conventional ( ) Other: _____

Please answer the following to the best of your ability:
( ) Yes (✓) No Does the site contain any jurisdictional wetlands?
( ) Yes (✓) No Is any non-domestic sewage (i.e. industrial) to be generated?
( ) Yes (✓) No Is the site subject to approval by any other public agency?

I have read this application and certify that the information provided herein is true, complete, and correct. Authorized county and state officials are granted right of entry to conduct necessary inspections to determine compliance with applicable laws and rules. I understand that I am solely responsible for the proper identification and labeling of all property lines and corners and making the site accessible so that a complete site evaluation can be performed.


Signature: Angie Love 9/21/2020
Property owner or owner's legal representative signature (SIGNATURE REQUIRED) DATE

IREDELL COUNTY HEALTH DEPARTMENT

ENVIRONMENTAL HEALTH DIVISION

PAGE 2: *SITE PLAN WORKSHEET*

SEE THE "SAMPLE SITE PLAN" BELOW. *INCOMPLETE SITE PLANS WILL BE RETURNED TO YOU FOR COMPLETION AND MAY RESULT IN A DELAY IN THE ISSUANCE OF YOUR SEPTIC SYSTEM PERMIT*!!!

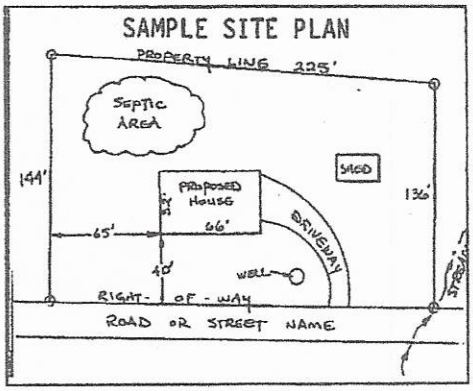

Place an (X) beside each item as you complete the site plan:


- (✓) Property Line measurements are clearly identified
- (✓) All proposed structures are indicated
- ( ) Front and side setbacks from property line N/A
- ( ) Preferred driveway location and well location N/A
- (✓) Area you prefer your septic system to be placed
- ( ) North arrow, or other sufficient indicator of direction

Circle N/A on the following if appropriate:

Location of septic systems and wells within 100' of your property	N/A
Location of easements and rights of ways on your property	N/A
Location of any designated wetlands on the property	N/A

USE THIS SPACE TO DRAW YOUR SITE PLAN

Show: proposed house or business footprint, wells, water lines, patios, pools and decks, and any other item that will occupy space on the site

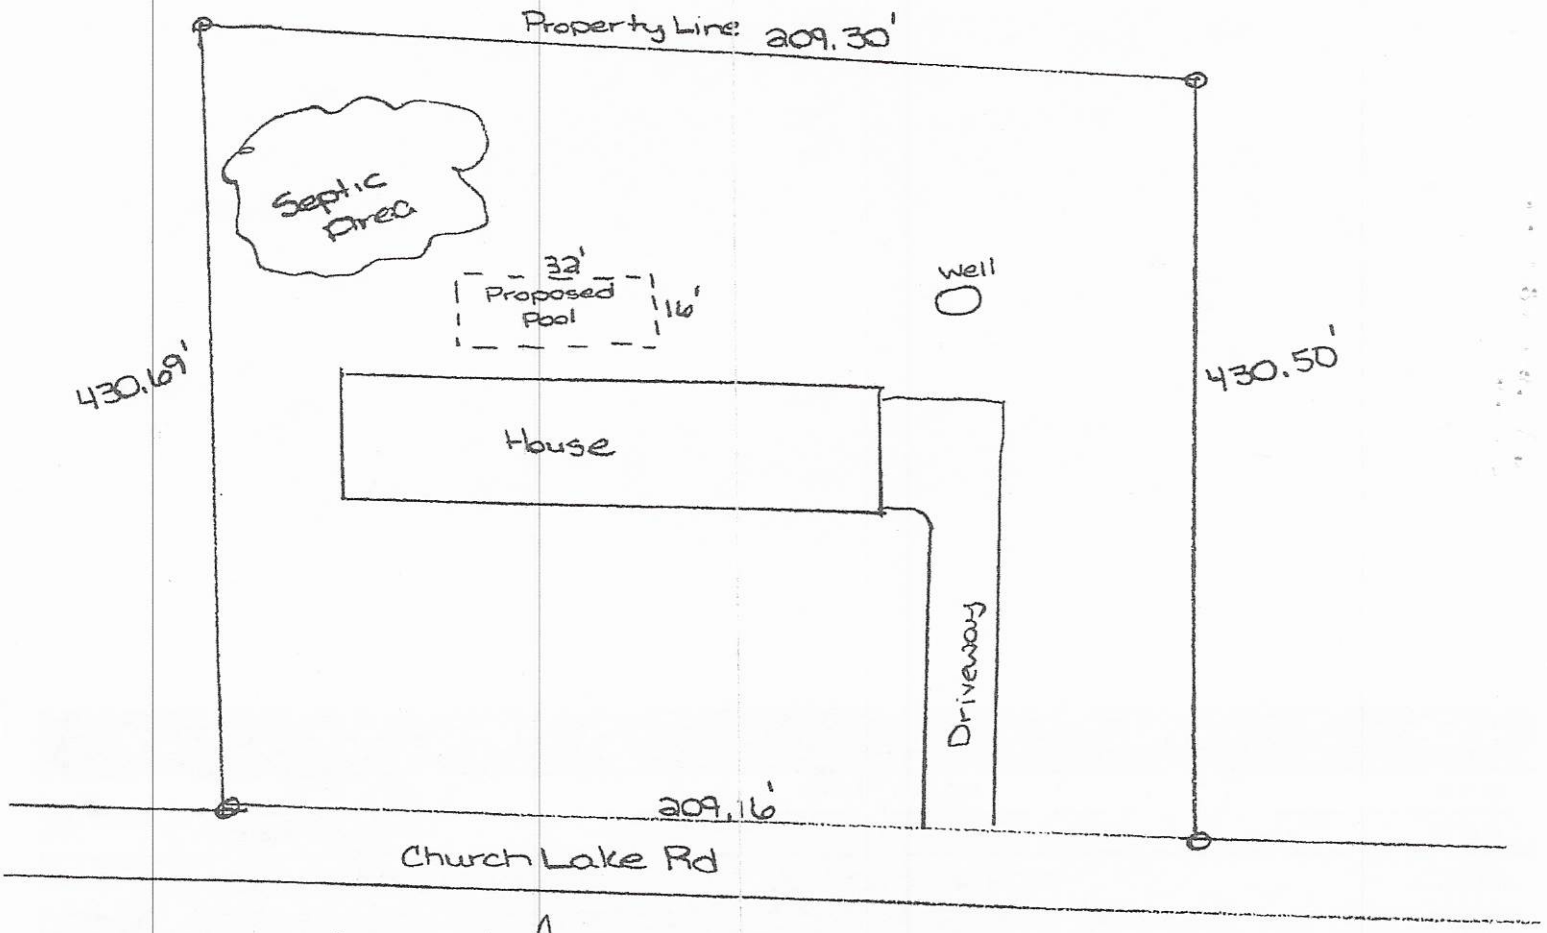

Signature: Angie Hunt

Property owner or owner's legal representative signature (**SIGNATURE REQUIRED**)

9/25/2020

DATE

108 Church Lake Rd. #4768-46-4284

IREDELL COUNTY HEALTH DEPARTMENT

37027

(SEPTIC TANK) IMPROVEMENTS PERMIT AND CERTIFICATE OF COMPLETION
(Ground Absorption Sewage Disposal System -- G. S. Chapter 130-Article 19C)

11109

OWNER OR CONTRACTOR LARRY LOVE DATE 11/27/90 PERMIT NO. 195-A-18

PHONE: Business _____ Home _____

LOCATION 21 N, TR CHURCHES LAKE - 2 mi ON (R)

_____ S. R. No. _____

SUBDIVISION NAME _____ LOT NO. _____ SECTION OR BLOCK NO. _____

House (✓) Mobile Home ( ) Business ( ) Other _____


No. Bedrooms 3 No. Bathrooms 2

Garbage Disposal Unit	Yes ( )	No (✓)	Character & Porosity of Soil	PS	
Auto. Dishwasher	Yes (✓)	No ( )	Percolation Rate	.4 gpm/ft2	
Auto. Wash. Machine	Yes (✓)	No ( )	Topography	2-8%	
Site Suitable	Yes (✓)	No ( )	Depth to Water Table	10'+	
			Rock or other impervious formations	NONE	

Lot Area 2 Ac

(✓) Basement with Plumbing ( ) Basement without Plumbing ( ) No Basement

TP 8/20/90

 

Plot of System

Size of Tank 1000 Gals.

Nitrification Field:
No. of Lines 3
Sq. Ft. 360 Linear Ft. 390
Depth of Stone in Lines 12"

Water Supply: Individual (✓)
Public ( )

Installed by TOMMY FRYE

I understand and agree to install septic tank system as specified on this Improvements Permit.

Signed: _____

IMPROVEMENTS PERMIT BY D. WEAVER

COMMENTS: _____

CERTIFICATE OF COMPLETION BY STEVEN HENDRICK DATE 11/27/90

EXISTING SYSTEM CHECKED BY: _____ DATE _____

CONSTRUCTION MUST COMPLY WITH ALL OTHER APPLICABLE STATE AND LOCAL REGULATIONS.

Permit is VOID if any unauthorized changes are made in installation of system and/or if any false information is supplied in making Improvements Permit.

Health Dept. Copy: White Inspection Dept. Copy: Yellow Sanitarian's Copy: Pink Owner's Copy: Gold

Public Health
Prevent. Promote. Protect.
Iredell County Health Department

IREDELL COUNTY DEPARTMENT OF ENVIRONMENTAL HEALTH

Public Health
Prevent. Promote. Protect.
Iredell County Health Department

DOCUMENTATION TO AUTHORIZE AN OWNER'S LEGAL REPRESENTATIVE

(Check and sign only ONE of the options below)

☑ **1. * APPLICANT AND OWNER ARE THE SAME. *** (*Sign here*) _____

Applications for permits require the "signature of the owner or owner's legal representative" (15A NCAC 18A .1937). If the owner does not sign the application himself or herself, they can submit any one of the following documents to designate their legal representative: *Power of Attorney; Real Estate Contract; Estate executor; Bankruptcy trustee; Court ordered guardianship*
In the absence of the above documentation, the property owner may provide the local health department with documentation that designates a legal representative. A property owner may:
Complete this form to document his or her legal representative, or provide his or her own form that contains the information in this form. If there are multiple property owners, then all property owners must sign the form that designates a legal representative.
By signing a form that designates a legal representative for purposes of 15A NCAC 18A .1937, the property owner authorizes that representative to act on their behalf in matters pertaining to the application and permitting process, including signing or receiving any application, document or permit. The owner retains full responsibility to meet all permit conditions specified by the local health department.

☐ **2.** I, _____, am the legal owner(s) of the property located at _____, identified as PIN (Parcel Identification Number)_____, located in Iredell County, North Carolina.

I do hereby authorize (**print legal representative/company name**) _____, _____, to act as an agent on my behalf in applying for/signing/obtaining any of the documents described below.

- Application for Improvement Permit (IP) / Authorization to Construct (AC)
- Improvement Permit (IP) / Authorization to Construct (AC)
- Application for soil-site evaluation (new/repair)
- Application/permit for private drinking water well/well abandonment
- Application for Compliance Inspection

I agree to abide by all decisions and/or conditions between the legal representative acting on my behalf and the Iredell County Department of Public Health, Environmental Health Division.

_____ _____
Signature of Owner(s) Date

Mooresville - Environmental Health
Fax: 704-662-3239
610 E. Center Avenue, Mooresville, NC 28115

Statesville - Environmental Health
ronda.hart@co.iredell.nc.us
Fax: 704-871-3483
349 N. Center Street, Statesville, NC 28677

IREDELL COUNTY · NC

IREDELL COUNTY
PO Box 788
349 North Center St.
Statesville, NC 28677

APPLICATION NUMBER
311255 Issue Date:

Permit Type: ZONING

Parcel Number	Street Address	Jurisdiction
4768464284.000	308 CHURCH LAKE RD	IREDELL COUNTY

Owner Information	Applicant Information
Name: LOVE LARRY K+SHERRY	Name: LOVE LARRY K+SHERRY
Address:	Address:
,	,
Phone:	Phone:

Use Requested	Zone Code
SWIMMING POOL	RA

Lot Acreage	F Setback	B Setback	L Setback	R Setback	Watershed	Flood Zone
2	150	10	10	10	N/A	NO

Remarks

POOL

Swimming Pool: Must meet requirement R22 of the LDC. Pools shall be located to comply with minimum setbacks for accessory structures- located behind front building line of house, 10' from side & rear property line. Lake lots must meet the 50' setback from the 760 contour line AND the 35' setback from the rear property line. Pools that are not an integral part of the principal building shall be located at least the minimum distance from the principal building necessary to comply with N.C. Building Code. Setback from house could be +/-10'. Fenced with a minimum 4' in height, and equipped with self-closing and positive self-latching gate provided with hardware for permanent locking. Fence not required for above ground pools if they are at least 4' in height, the ladder removed, or when NOT in use have a gate to the ladder as described above. SETBACK TO STRUCTURE COULD BE MORE OR LESS DEPENDING UPON THE BUILDING CODE; HOWEVER THERE IS A ? FT SET BACK FROM THE PROPERTY LINE.*The setback could change depending on the structure and size of the structure.


The applicant certifies that there are no deed restrictions, contractual agreements or governmental regulations of any kind that interfere with or prohibit the use of the property or the use for which this permit is requested. The applicant further acknowledges that enforcement of deed restrictions, plat conditions and other contractual agreements will not be undertaken by Iredell County and is the sole responsibility of the affected parties.

Date: 09/25/2020

Signature of Owner/Contractor

Permit Number	311255	TOTAL FEES:	$77.25

ZONING DISCLAIMER

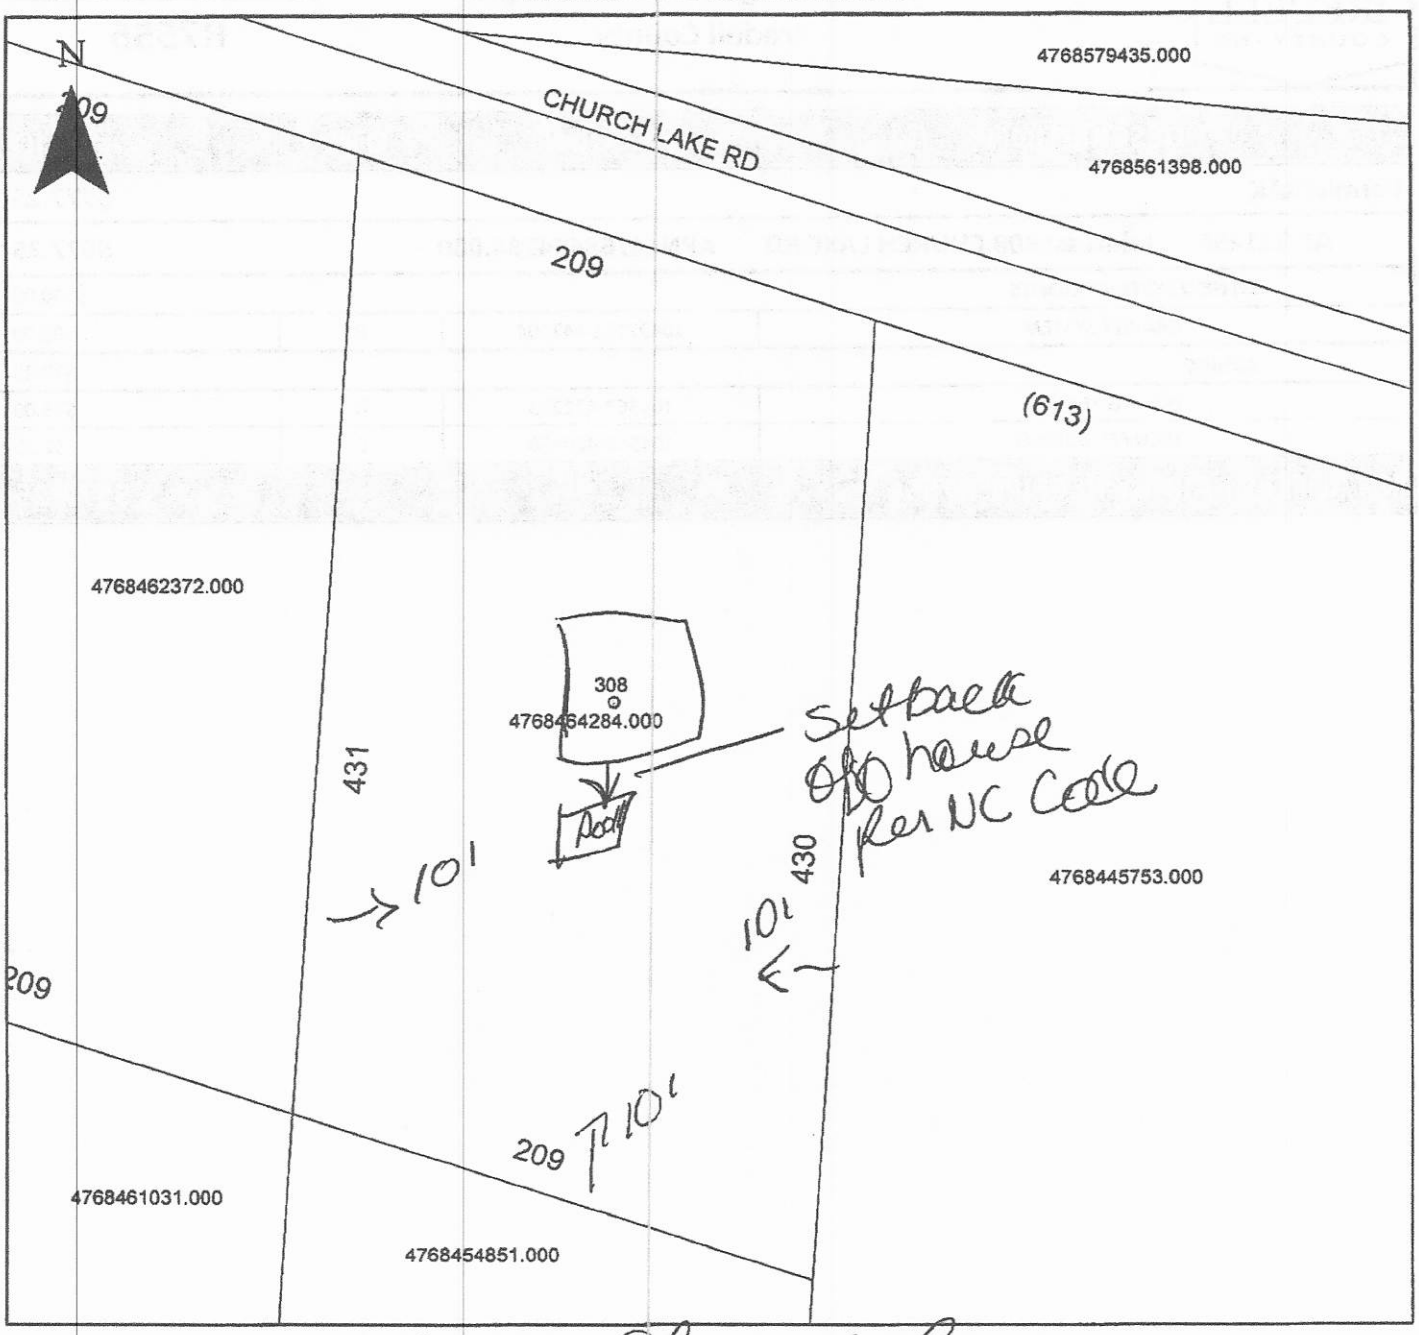

Property Address 308 Church Lake

The applicant certifies that there are no deed restrictions, contractual agreements or governmental regulations of any kind that interfere with or prohibit the use of the property or the use for which this permit is requested. Applicant further acknowledges that the enforcement of deed restrictions, plat conditions, and other contractual agreements will not be undertaken by Iredell County and is the sole responsibility of the affected parties.

A. Chen

Applicant

4/25/2022

Date