IREDELL COUNTY HEALTH DEPARTMENT

STATESVILLE 704-878-5305 MOORESVILLE 704-664-5281

J/CI

IMPROVEMENT PERMIT / AUTHORIZATION TO CONSTRUCT / OPERATION PERMIT / EXISTING SYSTEM INSPECTION

PERMIT# 109527 PIN# 4768-41-8577 DATE

OWNER OR CONTRACTOR J B RASH PHONE: Business 704-450-3622 Home 704-546-7664

ADDRESS 473 CHURCH LAKE RD STATESVILLE NC 28625

LOCATION O. MOORESVILLE 120 NORTH, (L) CHURCH'S LAKE (R) JACK FABB LANE, BEAR RT FORST DRIVE) THEN GATE ON FIELD

SUBDIVISION BLOCK / SECTION LOT LOT AREA 17.15 AC SITE CLASS PS DESIGN FLOW 360 L.T.A.R. .35

Septic Tank: 1000 Gallons: STB 1012 Date 7-5-02
Pump Tank: Gallons: PT Date
Pump Make: Model Serial No
Nitrification Field: No Fields 1 Square Feet 1020 Linear Feet 345'
No Lines 3X115' Trench Width 36" Max Trench Bottom Depth 36" Gravel Depth 12"

X New System ☐ Repair System Type: I, (II), III, IV, V, VI
System Description CONV 600 GAL
Repair System Description: 600 GAL 2 COMP REQ
Maintenance Agreement Required: ☐ Yes X No

☐ House/Mod. Home X Mobile Home ☐ Business ☐ Other
No. Bedrooms 3 No. Bathrooms 2 No. Employees


Water Supply: ☐ Individual X Public ☐ Community

☐ Slab X Crawl Space ☐ Basement w/plumbing ☐ Basement wo/plumbing


Comments/Conditions: (1) MEET PRIOR TO INSTALLATION FOR CONSULTATIVE INSPECT. (2) MAINTAIN SETBACKS & INSTALL LINES ON CONTOURS. (3) SHOOT

Comments/Conditions: ELEVATIONS & INSTALL SYSTEM SO FUTURE BASEMENT HOUSE CAN ACCOMODATE SYSTEM WITH NO BASEMENT PLUMBING. (4) SMOOTH OUT HUMPS & BUMPS IN FIELD.

INITIAL SITE SKETCH

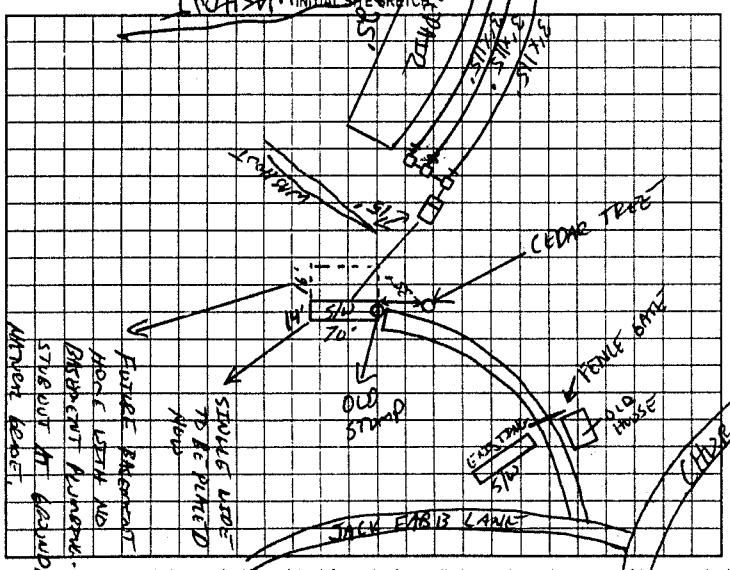

AS BUILT SKETCH

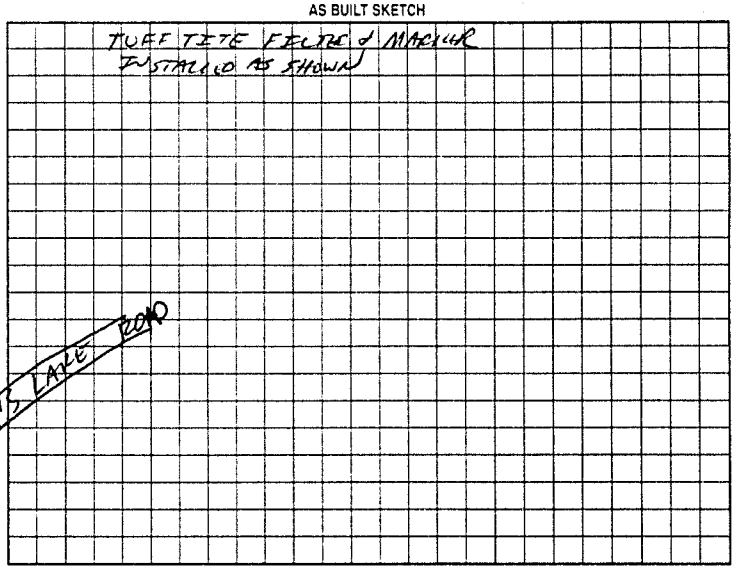

Permit can be suspended or revoked if any false information is supplied toward securing the permit/any unauthorized changes are made to the site/any unauthorized changes are made in the installation of the system. Improvement Permit with plat valid without expiration. Improvement Permit with site plan valid for sixty months. Authorization to Construct is valid for a period equal to that of Improvement Permit – not to exceed sixty months.

Signed: J.B. Rash date 10-29-02 Installed by: STEVE JORDAN & ASSOC.

Improvement Permit by: RS date 10-29-02 Operation Permit by: RS date 11-21-02

Authorization to Construct by: RS date 10-29-02 Existing System Inspection by: date

HEALTH DEPT. COPY. WHITE OWNER COPY (FINAL) YELLOW OWNER COPY (INITIAL) PINK