IREDELL COUNTY HEALTH DEPARTMENT

STATESVILLE 704-878-5305 MOORESVILLE 704-664-5281

IMPROVEMENT PERMIT / AUTHORIZATION TO CONSTRUCT / OPERATION PERMIT / EXISTING SYSTEM INSPECTION

PERMIT# D75274 PIN# 4768646672 DATE 8-5-98

OWNER OR CONTRACTOR Dana R Cope PHONE: Business 1800 255 4126 Ex 133 Home

ADDRESS 449 Church Lake Rd Statesville

LOCATION 21N TR Church Lake Rd 1.4 miles on left (1.4)

SUBDIVISION BLOCK / SECTION LOT LOT AREA SITE CLASS. P/S DESIGN FLOW 480 L.T.A.R. 0.3

Septic Tank: 1000 Existing Gallons; STB Date

Pump Tank: Gallons; PT Date

Pump Make: Model Serial No.

Nitrification Field: No Fields 1 Square Feet 399 Linear Feet 133

No Lines 2 Trench Width 36in Max Trench Bottom Depth 36in Gravel Depth 18

☒ New System ☐ Repair System Type: I, II, III, IV, V, VI

System Description: Gravity Conventional

Repair System Description: " "

Maintenance Agreement Required: ☐ Yes ☒ No

☒ House/Mod. Home ☐ Mobile Home ☐ Business ☐ Other

No. Bedrooms 4 No. Bathrooms 2 No. Employees


Water Supply: ☒ Individual ☐ Public ☐ Community

☐ Slab ☒ Crawl Space ☐ Basement w/plumbing ☐ Basement wo/plumbing


Comments:/Conditions: Keep lines on contour, 9ft on center, smooth out terraces, use 18in stone run sch40 pipe to lines in field = recommend pumping tank, keep cows off of new lines until good grass cover.

Comments:/Conditions: ① NEW SANITARY TEE INSTALLED IN SEPTIC TANK ② SEPTIC TANK PUMPED OUT 12-17-98

INITIAL SITE SKETCH

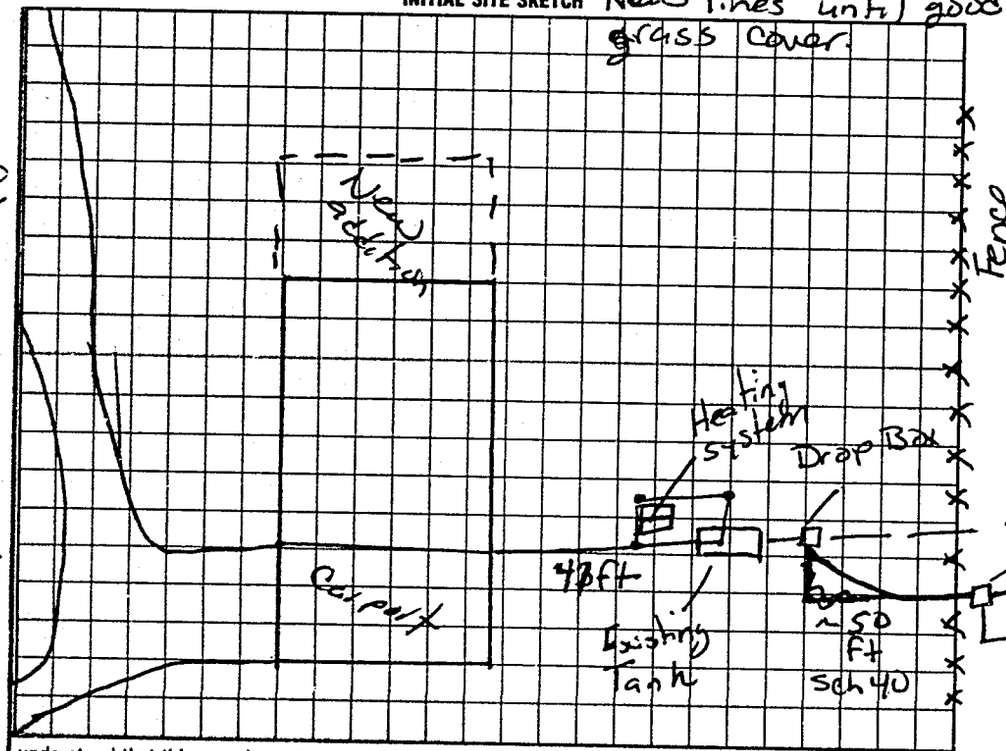

AS BUILT SKETCH

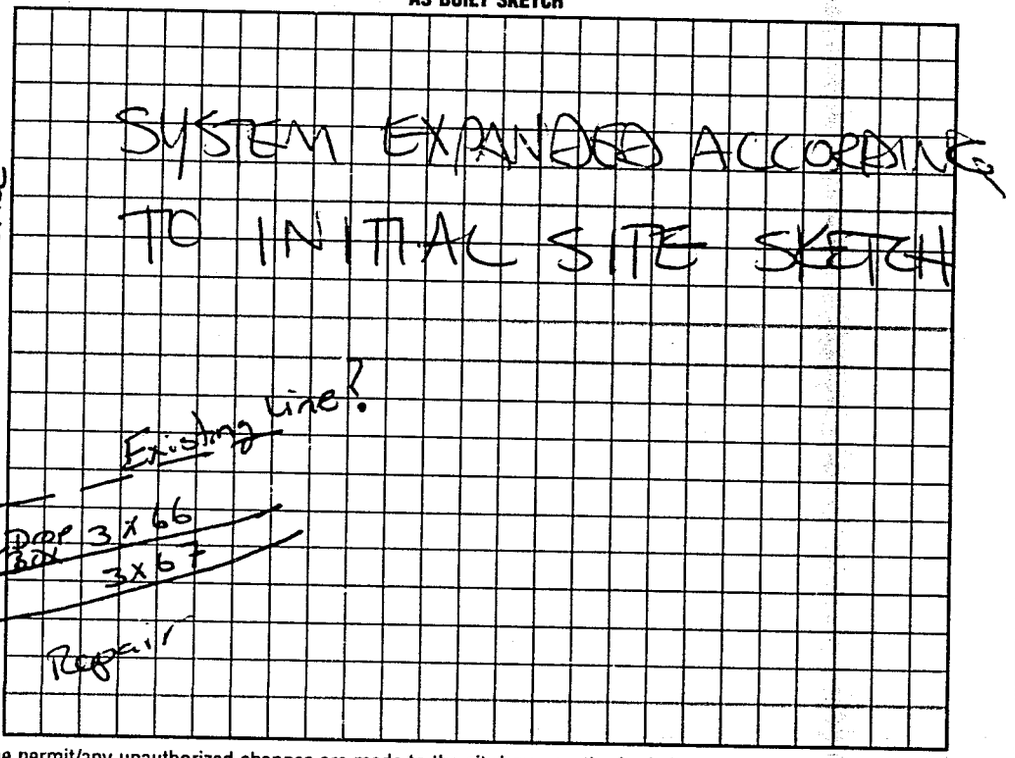

I understand that this permit can be suspended or revoked if any false information is supplied toward securing the permit/any unauthorized changes are made to the site/any unauthorized changes are made in the installation of the system. Improvement Permit with plat valid without expiration. Improvement Permit with site plan valid for sixty months. Authorization to Construct is valid for a period equal to that of Improvement Permit – not to exceed sixty months.

Signed: Edward Shumate date

Improvement Permit by: Mark C Ort RS date 8-5-98

Authorization to Construct by: Mark C Ort RS date 8-5-98

Installed by: KENNY MADISON

Operation Permit by: STEVE HENDRICK date 12-17-98

Existing System Inspection by: date

HEALTH DEPT. COPY WHITE INSPECTION COPY (FINAL) GREEN OWNER COPY (FINAL) YELLOW INSPECTION COPY (INITIAL) PINK OWNER COPY (INITIAL) GOLD