IREDELL COUNTY HEALTH DEPARTMENT - *ENVIRONMENTAL HEALTH* ☐ STATESVILLE OFFICE 704-878-5305 ☐ MOORESVILLE OFFICE 704-664-5281

IMPROVEMENT PERMIT / AUTHORIZATION TO CONSTRUCT / OPERATION PERMIT / EXISTING SYSTEM INSPECTION

PERMIT # 163990 PIN # 4768-65-0622 DATE DECEMBER 6, 2010

OWNER JAMES STEWART APPLICANT: PHONE: Home/Cell # 704 546-7783 Business #

SITE ADDRESS 384 CHURCH LAKE ROAD, STVL OWNER / APPLICANT ADDRESS

SITE DIRECTIONS US 21 NORTH, TR CHURCH LAKE ROAD, PROPERTY ON RIGHT AT BOX # 384, 1.0 MILE

SUBDIVISION BLOCK / SECTION LOT # LOT AREA 1.73 DESIGN FLOW 240 L.T.A.R. EXISTING

Septic Tank EXIST. Gallons: STB Date

Pump Tank Gallons: P T Date

Pump Make Model Serial #

No. Nitrification Fields: 1 No. Lines Linear Feet EXIST

Trench Width 3FT Max. Trench Bottom Depth Gravel Depth

☐ New System ☐ Repair ☐ Expansion System Type I (II) III IV V VI

System Description: CONVENTIONAL GRAVITY

Repair System Description:

Maintenance Agreement Required ☐ YES ☒ NO

☒ GRAVITY ☐ PRESSURE

☒ Residence No. Bedrooms 2

☐ Business No. Persons

☐ Other No. Employees

☐ Slab ☐ Crawl Space

☐ Basement w/plumbing ☒ Basement w/o plumbing

Water Supply: ☒ Private WELL ☐ Public ☐ Community

Comments / Conditions


PROPOSED NEW SHED DOES NOT INTERFERE WITH SEPTIC SYSTEM

INITIAL SITE SKETCH

AS BUILT SKETCH

~ SCALE: 1" = 40'

(THIS IS NOT A SURVEY)

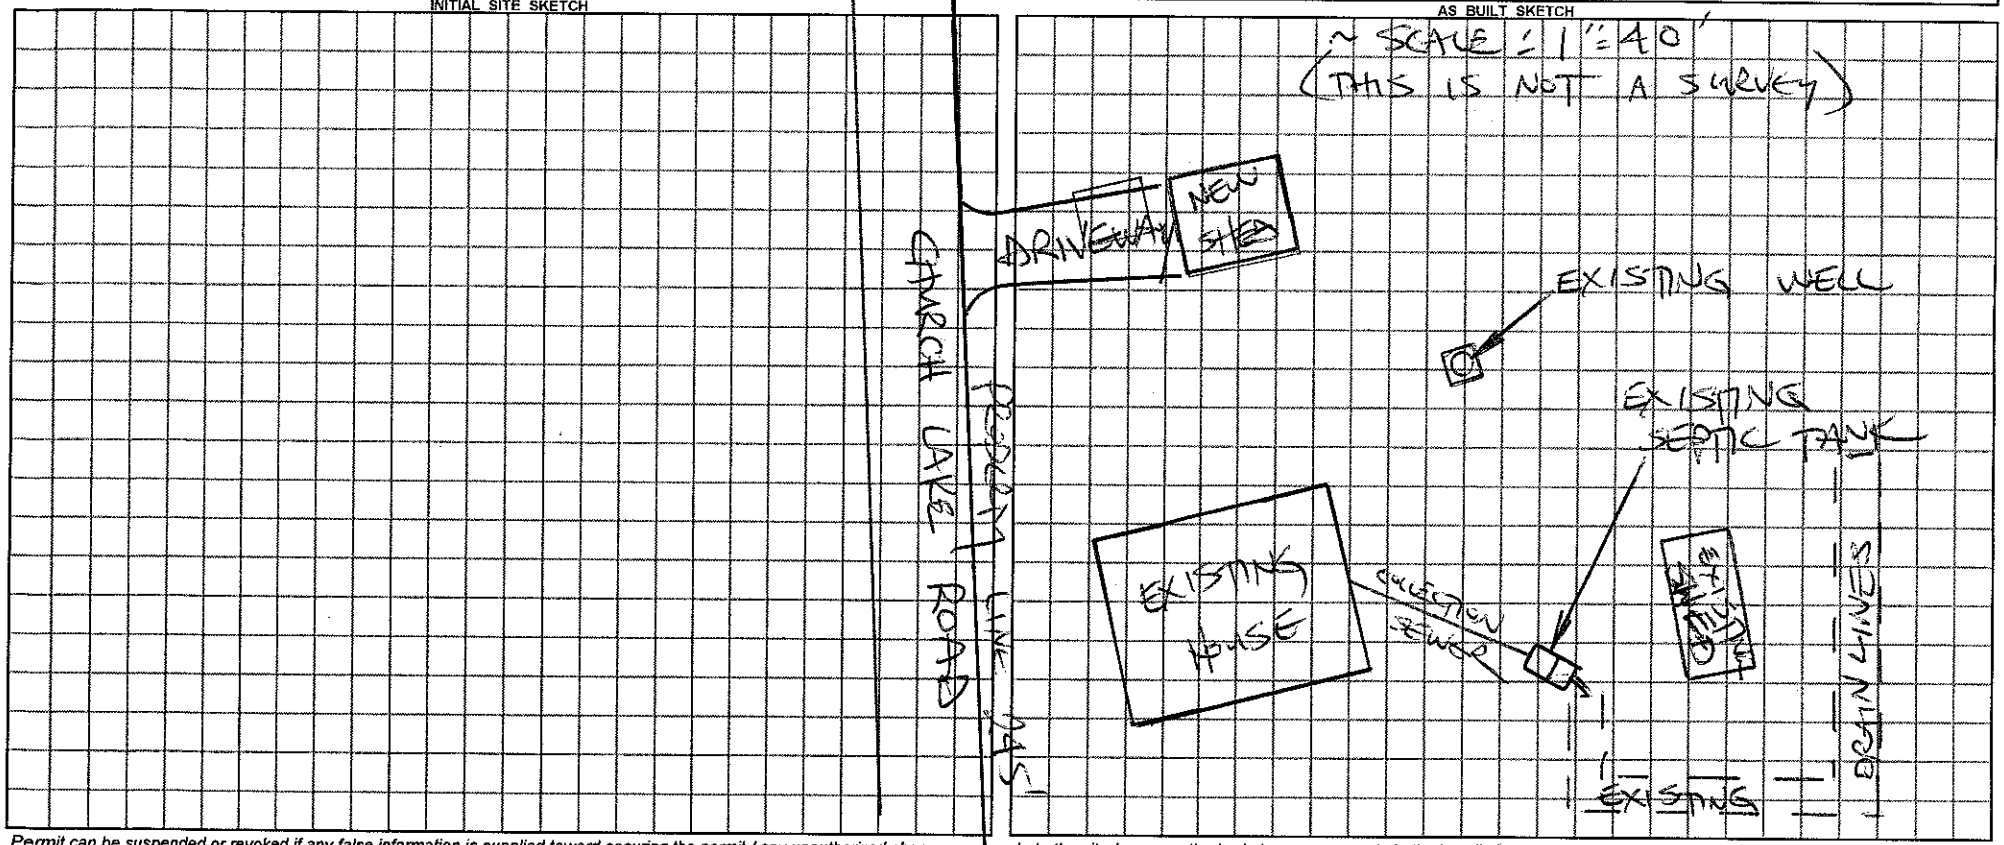

Permit can be suspended or revoked if any false information is supplied toward securing the permit / any unauthorized changes are made to the site / any unauthorized changes are made in the installation of the system.

☐ ***IMPROVEMENT PERMIT*** with plat valid without expiration. ☐ ***IMPROVEMENT PERMIT*** with plat valid without expiration. ☐ ***AUTHORIZATION TO CONSTRUCT*** valid for period equal to IMPROVEMENT PERMIT--not to exceed 60 mo.

Owner / Applicant Signature: Date

IMPROVEMENT PERMIT by: ***REHS*** Date

AUTHORIZATION TO CONSTRUCT by: ***REHS*** Date

YOU SHOULD CONTACT A LOCATOR SERVICE PRIOR TO ANY EXCAVATION

Installed by:

OPERATION PERMIT by: ***REHS*** Date

Existing System Inspected by: STEVE HEDRICK ***REHS*** Date 12-6-2010

White Copy – Environmental Health YELLOW COPY (Final) Owner / Applicant PINK COPY (Initial) Owner / Applicant