IREDELL COUNTY HEALTH DEPARTMENT

STATESVILLE 704-878-5305 MOORESVILLE 704-664-5281

IMPROVEMENT PERMIT / AUTHORIZATION TO CONSTRUCT / OPERATION PERMIT / EXISTING SYSTEM INSPECTION

PERMIT# 090012 PIN# 4768 88 0347 DATE 6-19-2000

OWNER OR CONTRACTOR ROGER HAGER PHONE: Business Home 876-2361

ADDRESS 287 NOEL ROAD HARMONY, NC 28634

LOCATION US 21 NORTH, TR NOEL ROAD, M/H 1 AT END TO LEFT

SUBDIVISION BLOCK / SECTION LOT LOT AREA 2.00 ACRES SITE CLASS PS DESIGN FLOW 240 L.T.A.R. EXISTING

Septic Tank: EXISTING Gallons; STB Date

Pump Tank: Gallons; PT Date

Pump Make: Model Serial No

Nitrification Field: No Fields 1 Square Feet Linear Feet EXISTING

No Lines Trench Width Max Trench Bottom Depth Gravel Depth

☐ New System ☐ Repair System Type: I (II) III. IV. V. VI

System Description: EXISTING CONV. GRAVITY

Repair System Description:

Maintenance Agreement Required: ☐ Yes ☑ No

☐ Slab ☑ Crawl Space ☐ Basement w/plumbing ☐ Basement wo/plumbing

☐ House/Mod. Home No. Bedrooms 2

☑ Mobile Home No. Bathrooms 1

☐ Business No. Employees


☐ Other

Water Supply: ☑ Individual ☐ Public ☐ Community WELL


Comments:/Conditions:

Comments:/Conditions

INITIAL SITE SKETCH

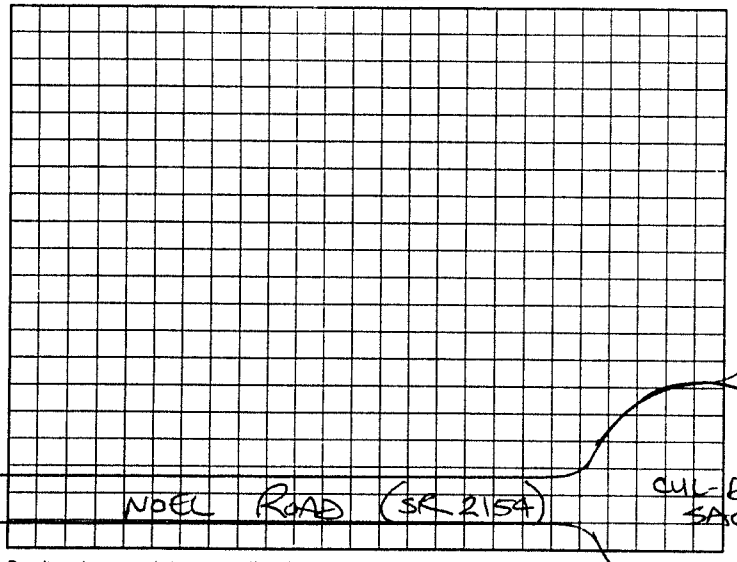

AS BUILT SKETCH

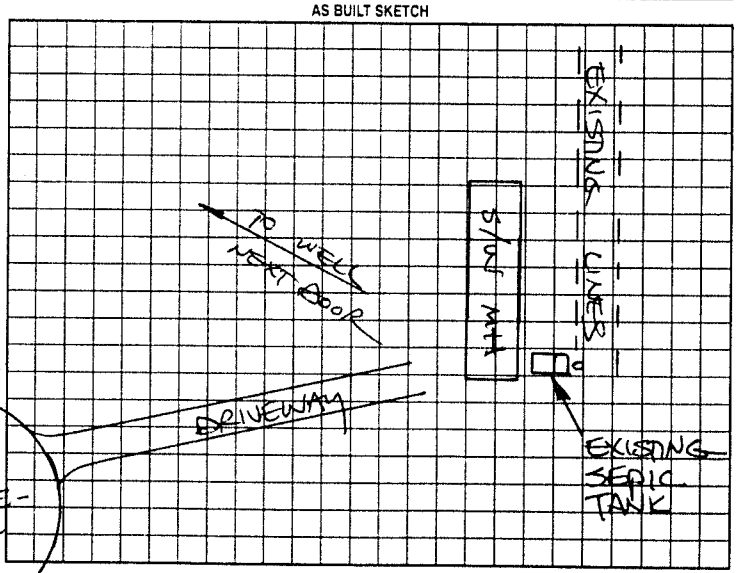

Permit can be suspended or revoked if any false information is supplied toward securing the permit/any unauthorized changes are made to the site/any unauthorized changes are made in the installation of the system. Improvement Permit with plat valid without expiration. Improvement Permit with site plan valid for sixty months. Authorization to Construct is valid for a period equal to that of Improvement Permit – not to exceed sixty months.

Signed: date Installed by:

Improvement Permit by: date Operation Permit by: date

Authorization to Construct by: date Existing System Inspection by: STEVE HEDRICK date 6-19-2000

HEALTH DEPT. COPY: WHITE OWNER COPY (FINAL) YELLOW OWNER COPY (INITIAL) PINK