IREDELL COUNTY HEALTH DEPARTMENT

STATESVILLE 704-878-5305 MOORESVILLE 704-664-5281

IMPROVEMENT PERMIT / AUTHORIZATION TO CONSTRUCT / OPERATION PERMIT / EXISTING SYSTEM INSPECTION

PERMIT# REPAIR PIN# 4768-88-9713 DATE 6-10-03

OWNER OR CONTRACTOR ROCKY CREEK CHURCH PHONE: Business Home

ADDRESS 205 CHADWICK ROAD, HARMONY, NC 28634

LOCATION US 21 NORTH, TR CHIEF THOMAS ROAD, TR CHADWICK RD, AT END ON LEFT

SUBDIVISION BLOCK / SECTION LOT LOT AREA 1.75 ACRE SITE CLASS. U DESIGN FLOW ~522 L.T.A.R. NONE GIVEN

Septic Tank: EXISTING 1000 Gallons; STB Date

Pump Tank: Gallons; PT Date

Pump Make: Model Serial No.

Nitrification Field: No Fields 1 Square Feet 1200 Linear Feet 400

No Lines FOUR Trench Width 36" Max Trench Bottom Depth 25" Gravel Depth 18"

☐ New System ☑ Repair System Type: I, II, (III), IV, V, VI

System Description:

Repair System Description: CONVENTIONAL GRAVITY

Maintenance Agreement Required: ☐ Yes ☑ No

☐ House/Mod. Home No. Bedrooms

☐ Mobile Home No. Bathrooms 4

☐ Business No. Employees

☑ Other CHURCH W/ 174 SEATS


☐ Slab ☐ Crawl Space ☐ Basement w/plumbing ☐ Basement wo/plumbing

Water Supply: ☐ Individual ☐ Public ☑ Community WELL


Comments:/Conditions: THIS PERMIT SERVES AS "NOTICE OF VIOLATION", SYSTEM TO BE REPAIRED BY 7-11-2003, USING 18" STONE ON CONTOUR.

Comments:/Conditions: INITAL SYSTEM INSTALLED IN UNSUITABLE SOIL DEPTH & EXPANSIVENESS — AS WELL AS THIS REPAIR PERMIT ISSUED WITH "BEST PROFESSIONAL JUDGEMENT"

INITIAL SITE SKETCH

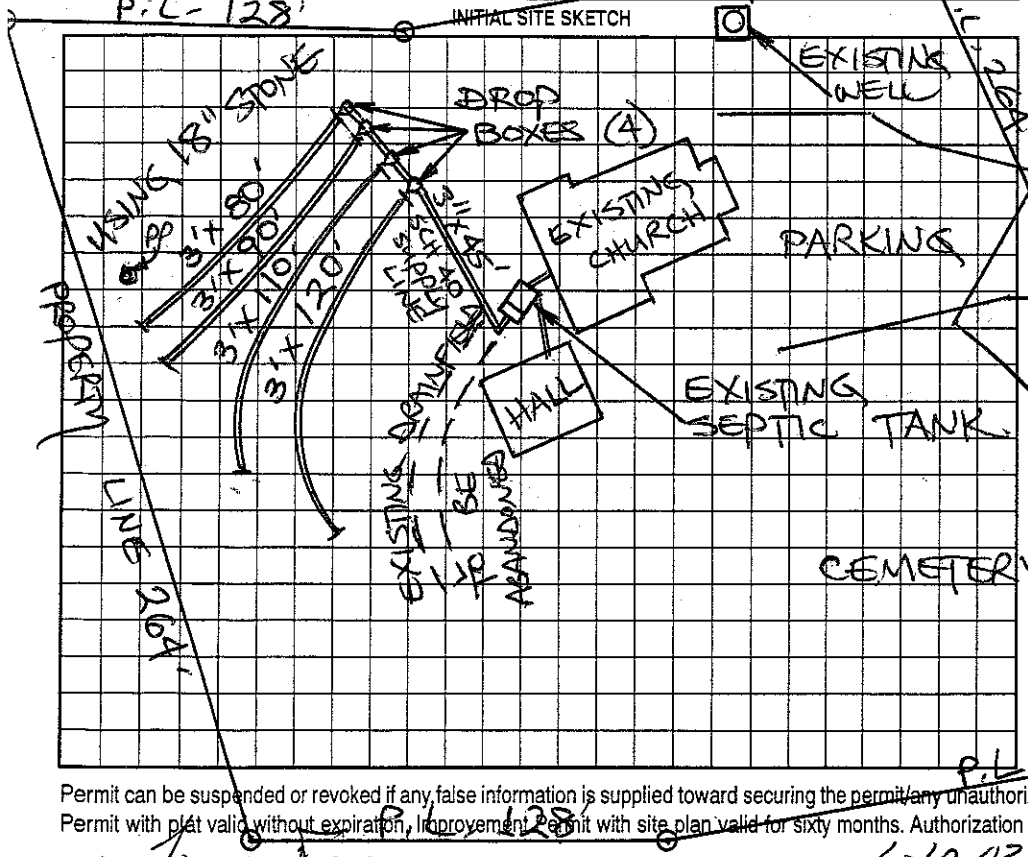

AS BUILT SKETCH

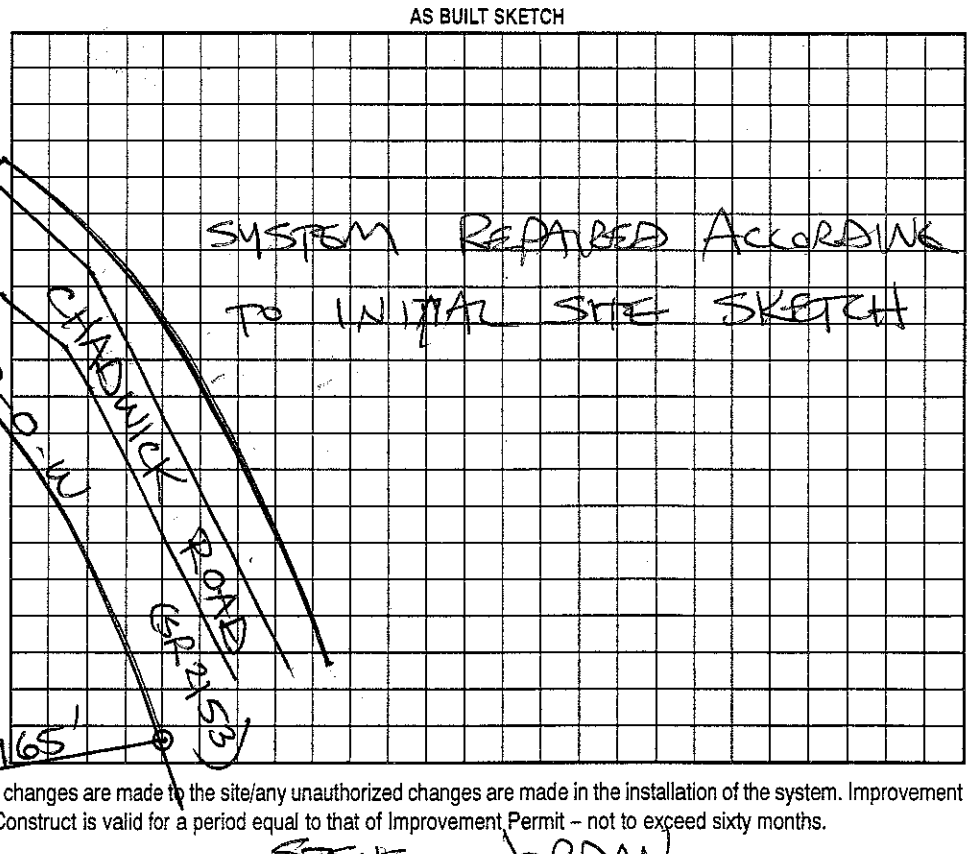

Permit can be suspended or revoked if any false information is supplied toward securing the permit/any unauthorized changes are made to the site/any unauthorized changes are made in the installation of the system. Improvement Permit with plat valid without expiration, Improvement Permit with site plan valid for sixty months. Authorization to Construct is valid for a period equal to that of Improvement Permit – not to exceed sixty months.

Signed: date 6-10-03 Installed by: STEVE JORDAN

Improvement Permit by: STEVE HEDRICK date 6-10-03 Operation Permit by: STEVE HEDRICK date 7-16-03

Authorization to Construct by: STEVE HEDRICK date 6-10-03 Existing System Inspection by: date

HEALTH DEPT. COPY: WHITE OWNER COPY (FINAL): YELLOW OWNER COPY (INITIAL): PINK