IREDELL COUNTY HEALTH DEPARTMENT

STATESVILLE 704-878-5305 MOORESVILLE 704-664-5281

IMPROVEMENT PERMIT / AUTHORIZATION TO CONSTRUCT / OPERATION PERMIT / EXISTING SYSTEM INSPECTION

PERMIT# 088014 PIN# 4768 96 9537 DATE 3-3-00

OWNER OR CONTRACTOR AMERICAN LAND PHONE: Business 878-9595 Home

ADDRESS 1281 GARNER BAGNAL BLVD, STATESVILLE, NC 28677

LOCATION US 21 N, TR CHIEF THOMAS, TR HARMONY BLEND, LOT AT END OFF CUL-DE-SAC

SUBDIVISION EASTEN ACRES BLOCK / SECTION LOT 20 LOT AREA 4.46 ACRES SITE CLASS PS DESIGN FLOW 360 L.T.A.R. 0.30 GPD/FT²

Septic Tank: 1000 Gallons; STB 1012 Date 11-8-99

Pump Tank: Gallons; PT Date

Pump Make: Model Serial No.

Nitrification Field: No Fields 1 Square Feet EQ. TO 1200 Linear Feet 300 FT

No Lines FIVE Trench Width 36" Max Trench Bottom Depth 30" Gravel Depth SAND 6"

☑ New System ☐ Repair System Type: I, II, III, IV, V, VI

System Description: 25% REDUCTION CHAMBERS

Repair System Description: 25% REDUCTION PUMP

Maintenance Agreement Required: ☐ Yes ☑ No

☐ House/Mod. Home ☑ Mobile Home ☐ Business ☐ Other

No. Bedrooms 3 No. Bathrooms 2 No. Employees


☐ Slab ☐ Crawl Space ☐ Basement w/plumbing ☐ Basement wo/plumbing

Water Supply: ☑ Individual ☐ Community


Comments/Conditions: ① KEEP SYSTEM MINIMUM 100 FEET FROM WELL
② INSTALL FIFTY CHAMBERS IN FIVE EQUAL LENGTH LINES
③ INSTALL SUBSURFACE INTERCEPT DRAINAGE DITCH AS SHOWN BEGINNING 32" DEEP OUT TO DAYLIGHT

Comments/Conditions: SEPTIC TANK W/ MARKER INSTALLED USING "POLYLOK" FILTER

INITIAL SITE SKETCH

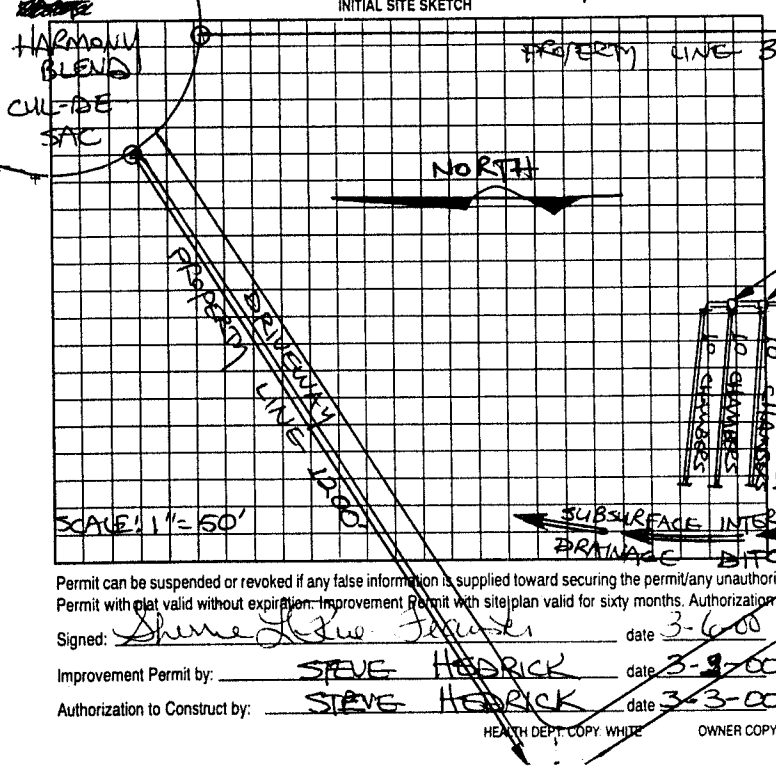

AS BUILT SKETCH — SAME

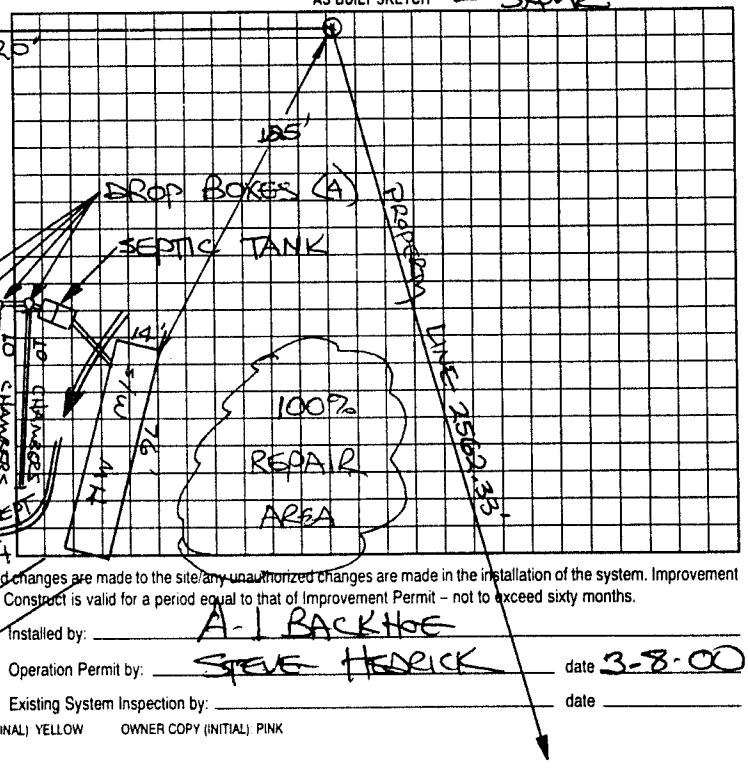

Permit can be suspended or revoked if any false information is supplied toward securing the permit/any unauthorized changes are made to the site/any unauthorized changes are made in the installation of the system. Improvement Permit with plat valid without expiration. Improvement Permit with site plan valid for sixty months. Authorization to Construct is valid for a period equal to that of Improvement Permit – not to exceed sixty months.

Signed: [signature] date 3-6-00 Installed by: A-1 BACKHOE

Improvement Permit by: STEVE HEDRICK date 3-3-00 Operation Permit by: STEVE HEDRICK date 3-8-00

Authorization to Construct by: STEVE HEDRICK date 3-3-00 Existing System Inspection by: date

HEALTH DEPT. COPY: WHITE OWNER COPY (FINAL): YELLOW OWNER COPY (INITIAL): PINK