IREDELL COUNTY HEALTH DEPARTMENT

STATESVILLE 704-878-5305 MOORESVILLE 704-664-5281

IMPROVEMENT PERMIT / AUTHORIZATION TO CONSTRUCT / OPERATION PERMIT / EXISTING SYSTEM INSPECTION

PERMIT# 088014 PIN# 4768-96-9537 DATE 1/28/04

OWNER OR CONTRACTOR AMERICAN LAND CORP. PHONE: Business 704-878-9595 Home

ADDRESS 1281 GARNER BAGNAL BLVD. STATESVILLE 28677

LOCATION 21N @ CHIEF THOMAS @ HARMONY BLEND LOT #20 @ END OF CUL-DE-SAC

SUBDIVISION EASTON ACRES BLOCK / SECTION LOT 20 LOT AREA 4.46 AC SITE CLASS. RS DESIGN FLOW 360 L.T.A.R. .36PD/FT²

Septic Tank: 1000 Gallons; STB 1012 Date 11-8-99
Pump Tank: Gallons; PT Date
Pump Make: Model Serial No.
Nitrification Field: No Fields 1 Square Feet EQ 1200 Linear Feet 300
No Lines 5 Trench Width 36" Max Trench Bottom Depth 30" Gravel Depth N/A

☑ New System ☐ Repair System Type: I, II, (III), IV, V, VI
System Description: 25% REDUCTION CHAMBERS
Repair System Description: 25% REDUCTION PUMP
Maintenance Agreement Required: ☐ Yes ☑ No


☐ House/Mod. Home No. Bedrooms 3
☑ Mobile Home No. Bathrooms 2
☐ Business No. Employees
☐ Other
☐ Slab ☑ Crawl Space ☐ Basement w/plumbing ☐ Basement wo/plumbing

Water Supply: ☑ Individual ☐ Public ☐ Community


Comments:/Conditions:

Comments:/Conditions: ① SYSTEM FUNCTIONING PROPERLY AT TIME OF INSPECTION. ② NEW DWELLING SHALL NOT INCREASE NUMBER OF BEDROOMS ON EXISTING SYSTEM ③ THIS DESCRIBES SYSTEM AT TIME OF INSPECTION ONLY, AND THERE IS NO GUARANTEE PROBLEMS WILL NOT ARISE IN FUTURE.

INITIAL SITE SKETCH

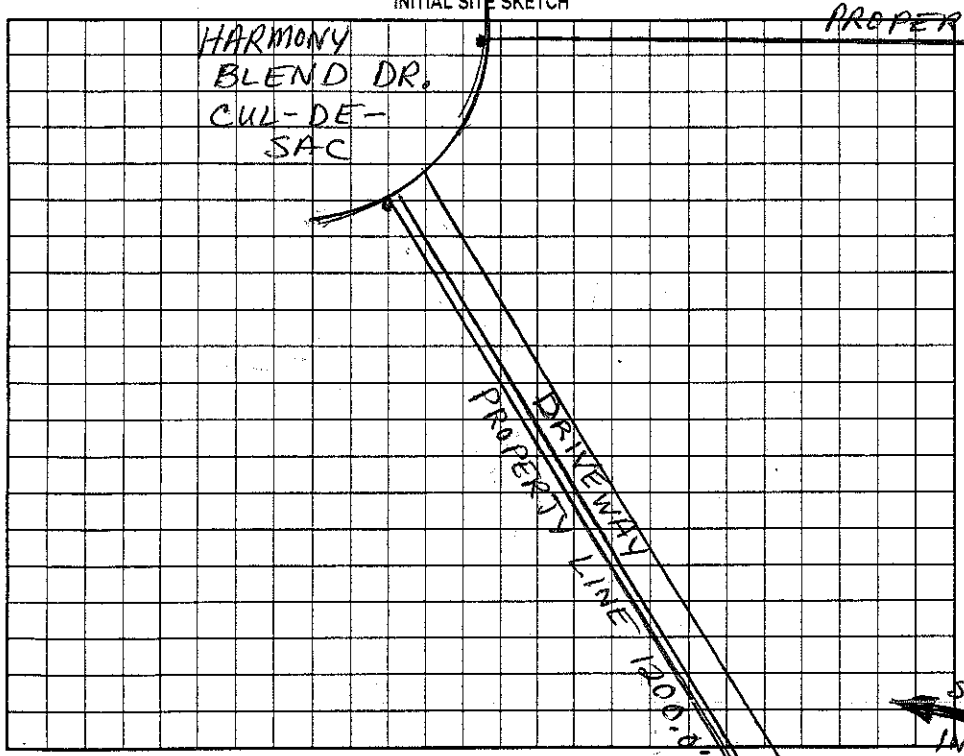

AS BUILT SKETCH

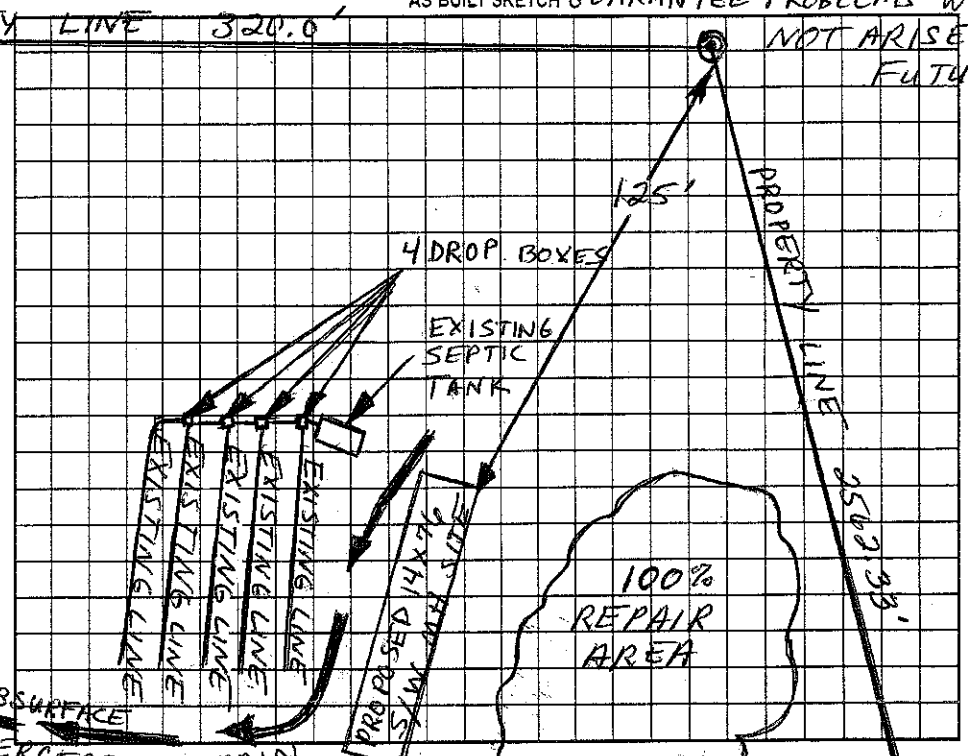

Permit can be suspended or revoked if any false information is supplied toward securing the permit/any unauthorized changes are made to the site/any unauthorized changes are made in the installation of the system. Improvement Permit with plat valid without expiration. Improvement Permit with site plan valid for sixty months. Authorization to Construct is valid for a period equal to that of Improvement Permit - not to exceed sixty months.

Signed: date

Improvement Permit by: date

Authorization to Construct by: date

Installed by: A-1 Backhoe

Operation Permit by: date

Existing System Inspection by: Christopher M. Sherrill, R.S. date 1-28-04

HEALTH DEPT. COPY: WHITE OWNER COPY (FINAL): YELLOW OWNER COPY (INITIAL): PINK