IREDELL COUNTY HEALTH DEPARTMENT - *ENVIRONMENTAL HEALTH* ☒ STATESVILLE OFFICE 704-878-5305 ☐ MOORESVILLE OFFICE 704-664-5281

IMPROVEMENT PERMIT / AUTHORIZATION TO CONSTRUCT / OPERATION PERMIT / EXISTING SYSTEM INSPECTION

PERMIT # 17534 7 PIN # 4769319210 DATE 10/22/12

OWNER Stewart Holdings APPLICANT: PHONE: Home/Cell # 704-902-4015 Business #

SITE ADDRESS 2289 Turnersburg OWNER / APPLICANT ADDRESS

SITE DIRECTIONS 21 N, past Cattle Auction, on left

SUBDIVISION n/a BLOCK / SECTION n/a LOT # n/a LOT AREA 70.74 DESIGN FLOW 375 L.T.A.R. .3

Septic Tank 1000 Gallons: STB 760 Date 6-20 ☒ New System ☐ Repair ☐ Expansion System Type I II III IV V VI

Pump Tank Gallons: PT Date System Description: 25% Reduction - Gravity

Pump Make Model Serial # Repair System Description: 25% Reduction - Gravity

No. Nitrification Fields: 1 No. Lines 3 Linear Feet 316 Maintenance Agreement Required ☐ YES ☒ NO

Trench Width 36" Max. Trench Bottom Depth 36" Gravel Depth n/a ☒ GRAVITY ☐ PRESSURE


☐ Residence No. Bedrooms ☒ Business No. Persons ☐ Other No. Employees 15 ☒ Slab ☐ Crawl Space ☐ Basement w/plumbing ☐ Basement w/o plumbing

Water Supply: ☒ Private ☐ Public ☐ Community


Comments / Conditions: Use serial distribution.

Red Polylok Filters installed - Quicket Chambers installed

INITIAL SITE SKETCH

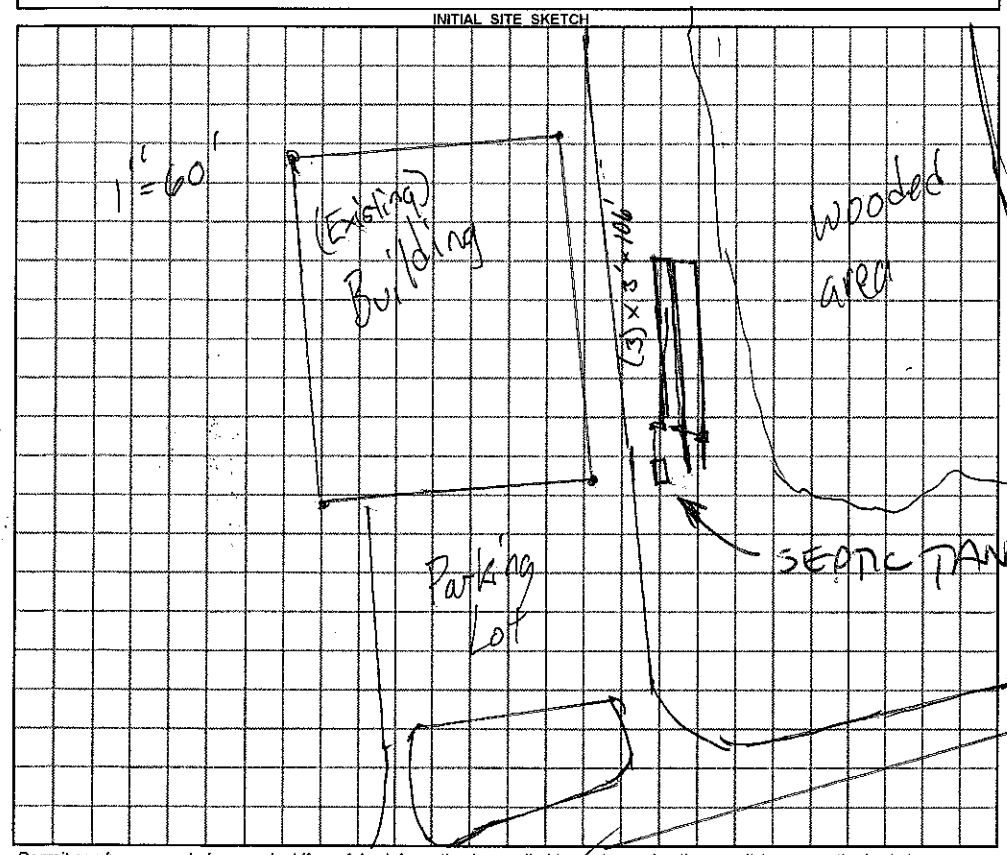

AS BUILT SKETCH

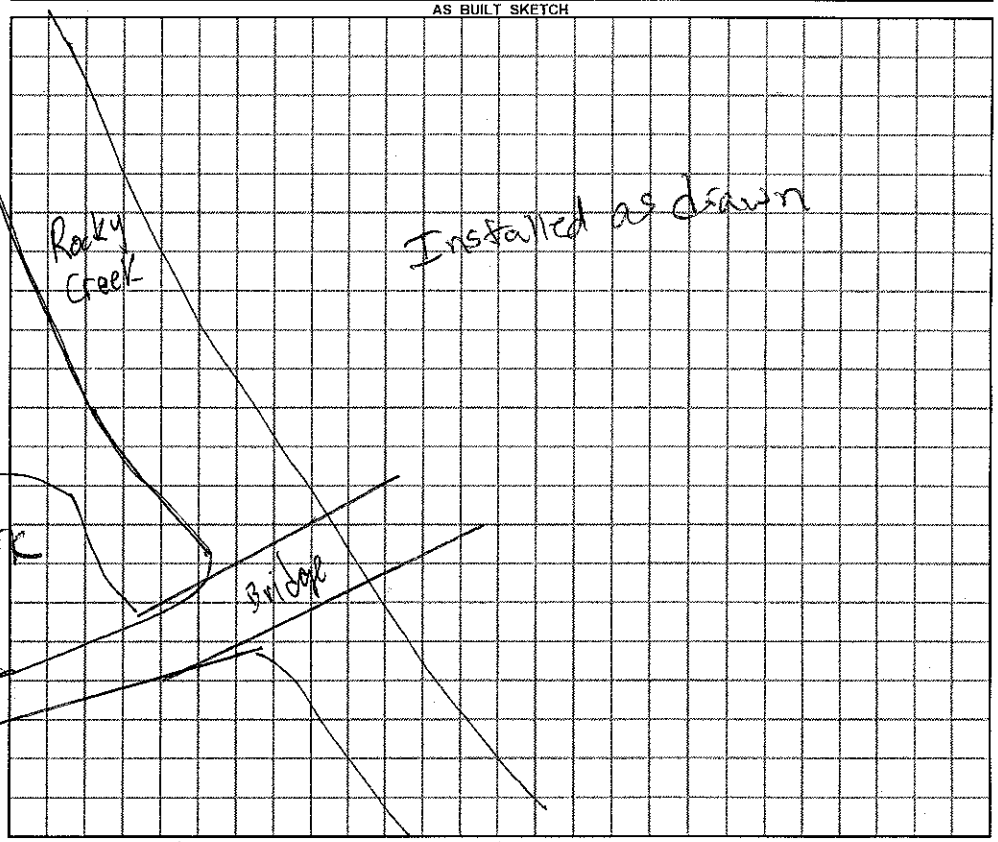

Permit can be suspended or revoked if any false information is supplied toward securing the permit / any unauthorized changes are made to the site / any unauthorized changes are made in the installation of the system.

☐ ***IMPROVEMENT PERMIT*** *with plat valid without expiration.* ☒ ***IMPROVEMENT PERMIT*** *with plat valid without expiration.* ☒ ***AUTHORIZATION TO CONSTRUCT*** valid for period equal to IMPROVEMENT PERMIT--not to exceed 60 mo.

Owner / Applicant Signature: Dennis Gallek Date 10-22-12 *site plan valid 60 mo.* Installed by: A1 Backhoe

IMPROVEMENT PERMIT by: REHS Date 10/22/12 OPERATION PERMIT by: Justin Henderson REHS Date 10-23-12

AUTHORIZATION TO CONSTRUCT by: REHS Date 10/22/12 Existing System Inspected by: REHS Date

YOU SHOULD CONTACT A LOCATOR SERVICE PRIOR TO ANY EXCAVATION

White Copy – Environmental Health YELLOW COPY (Final) Owner / Applicant PINK COPY (Initial) Owner / Applicant