IREDELL COUNTY HEALTH DEPARTMENT

STATESVILLE 704-878-5305 (a) (a) MOORESVILLE 704-664-5281

IMPROVEMENT PERMIT / AUTHORIZATION TO CONSTRUCT / OPERATION PERMIT / EXISTING SYSTEM INSPECTION

PERMIT # 152955 PIN # 4769375811 DATE 10/21/08

OWNER or APPLICANT Donna Stewart PHONE: Business 704 682 9959 Home: 704 252 0500

OWNER or APPLICANT ADDRESS 181 Stone Creek Dr.

LOCATION / DIRECTIONS I77 N to Tomlin Mill Rd (R) site on (R) past Rash

SUBDIVISION n/a BLOCK / SECTION n/a LOT # n/a LOT AREA 30.823 DESIGN FLOW 480 L.T.A.R. .25

Septic Tank 1000 Gallons: STB 620 Date 7-9-08

Pump Tank ____ Gallons: P T ____ Date ____

Pump Make ____ Model ____ Serial # ____

Nitrification Field No Fields 1 No Lines 4 Linear Feet 480

Trench Width 36 Max. Trench Bottom Depth 36" Gravel Depth n/a

☒ New System ☐ Repair ☐ Expansion System Type I II III IV V VI

System Description: 25% Reduction, Gravity

Repair System Description: 25% Reduction Gravity

Maintenance Agreement Required ☐ YES ☒ NO

☒ GRAVITY ☐ PRESSURE

☒ Residence No. Bedrooms 4

☐ Business No. Persons ____

☐ Other No. Employees ____

☐ Slab ☐ Crawl Space


☒ Basement w/plumbing ☐ Basement w/o plumbing

Water Supply: ☐ Private ☒ Public ☐ Community

Comments / Conditions

Comments / Conditions

INITIAL SITE SKETCH

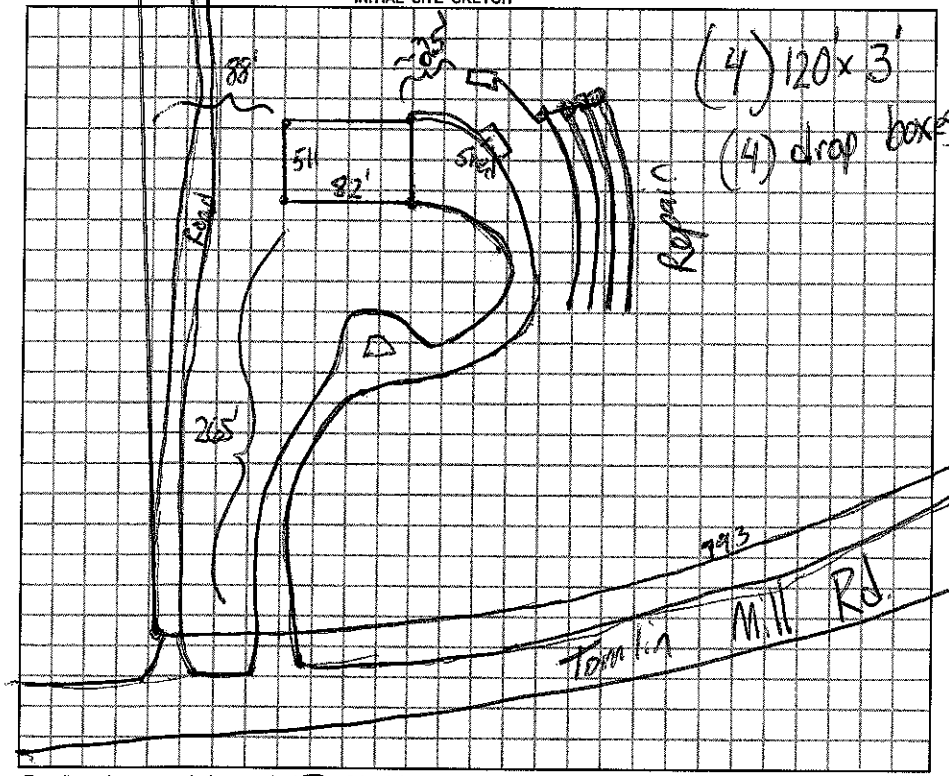

AS BUILT SKETCH

Permit can be suspended or revoked if any false information is supplied toward securing the permit / any unauthorized changes are made to the site / any unauthorized changes are made in the installation of the system.

☐ *IMPROVEMENT PERMIT w / plat valid without expiration.* ☒ *IMPROVEMENT PERMIT w / site plan valid for 60 mos.* ☒ *AUTHORIZATION TO CONSTRUCT valid for period equal to IMPROVEMENT PERMIT-not to exceed 60 mo.*

Owner / Applicant Signature: [signature] Date 10/22/08

Improvement Permit by: [signature] Date 10/21/08

Authorization to Construct by: [signature] Date 10/22/08

Installed by: Steve Jordan

Operation Permit by: [signature] Date: 10-27-08

Existing System Inspected by: ____ Date: ____

YOU SHOULD CONTACT A LOCATOR SERVICE PRIOR TO ANY EXCAVATION.

WHITE COPY Environmental Health YELLOW COPY (Final) Owner / Applicant PINK COPY (Initial) Owner / Applicant