IREDELL COUNTY HEALTH DEPARTMENT

Statesville Office (704) 878-5305 Mooresville Office (704) 660-3625

IMPROVEMENT PERMIT / AUTHORIZATION TO CONSTRUCT / OPERATION PERMIT / EXISTING SYSTEM

PERMIT # 181403

APPLICANT: Moorefield Builders Inc APPLICANT ADDRESS: 1516 Mocksville Hwy

PIN # 4769375811

SITE ADDRESS: 245 Tomlin Mill Rd. PHONE: 704-873-1885 ALT. PHONE: 704-880-6620

SITE DIRECTIONS: Hwy 21 N TL Tabor Rd TL Tomlin Mill Rd. Property on Left

SUBDIVISION: N/A SECTION: N/A LOT # N/A LOT AREA: 30.8 acres DESIGN FLOW: 480gpd L.T.A.R.: Existing

Septic Tank Existing (gal) STB Date

Pump Tank (gal) PT Date

Pump Make Model Serial #

Nitrification Fields 1 # Lines 4 Linear Ft: 6x

Trench Width 6x Max. Trench Bottom Depth 6x Gravel Depth 6x

☐ New System ☐ Repair ☐ Expansion System Type: I II ☒ IV V VI

System Description: 25% Reduction

Repair System Description:

Maintenance Agreement Required: ☐ YES ☑ NO

☑ GRAVITY ☐ PRESSURE

☑ Residence ☐ Business ☐ Other ☐ Slab ☑ Basement w/plumbing

No. Bedrooms 4 No. Persons No. Employees ☐ Crawl Space ☐ Basement w/o plumbing


Water Supply: ☐ Private ☑ Public ☐ Community

Comments / Conditions:

- Maintain a minimum of 5' between garage foundation & all components of septic tank system.

INITIAL SITE SKETCH

AS BUILT SKETCH

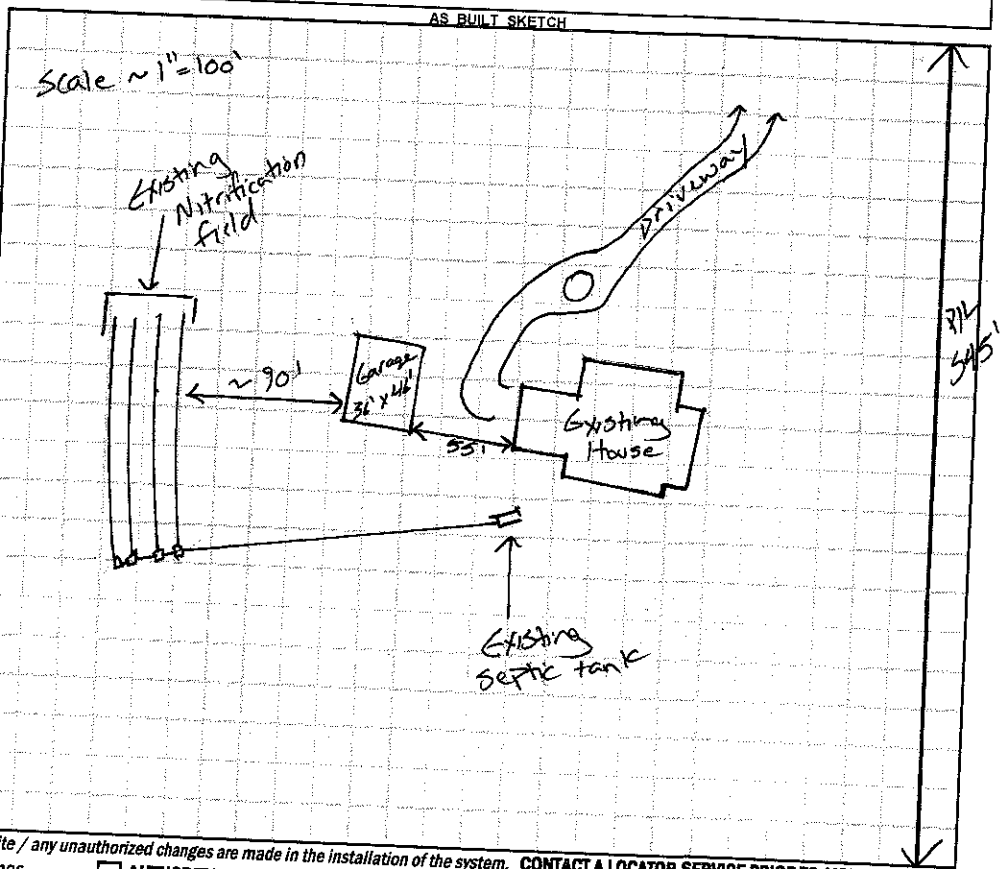

Permit can be suspended or revoked if any false information is supplied toward securing the permit / any unauthorized changes are made to the site / any unauthorized changes are made in the installation of the system. **CONTACT A LOCATOR SERVICE PRIOR TO ANY EXCAVATION**

☐ **IMPROVEMENT PERMIT** ***with plat*** *valid without expiration.* ☐ **IMPROVEMENT PERMIT** ***with site plan*** *valid for 60 mos.* ☐ **AUTHORIZATION TO CONSTRUCT** *valid for period equal to IMPROVEMENT PERMIT--not to exceed 60 mo.*

Owner / Applicant Signature: Date: Installed by:

IMPROVEMENT PERMIT by: Date: OPERATION PERMIT by: Date:

AUTHORIZATION TO CONSTRUCT by: Date: Existing System Inspected by: Justin Henderson Date: 10-21-13

Health Dept. Copy - WHITE Applicant (Final Approval) - YELLOW Applicant (Conditional Approval) - PINK