IREDELL COUNTY HEALTH DEPARTMENT

Statesville Phone TR 3-7271 Mooresville Phone NO 3-1271

PERMIT TO INSTALL SEPTIC TANK

Permit No. 398 Permit Date 11-18 1969

Owner Boyd Hager Address R4 Turnersburg Statesville, N C

Installed By Smith & Sedgert Sons Address R1 Statesville, NC


Location of Property Hwy 21 N Crossbridge pass Turnersburg 1st Rd. R1 2154 Trailer on left dead End

Tank		Capacity		Length of Lines		Fixtures	
Block	( )	1000	(✓)	225'	(✓)	No. of Baths	( )
Precast	( )	1250	( )	250'	( )	Dishwasher	( )
		1500	( )	Other		Garbage Grdr.	( )
		Other				Other	

NOTIFY HEALTH DEPARTMENT AT LEAST EIGHT HOURS BEFORE TANK IS TO BE INSPECTED.

Final Inspection 11-18 1969 Approved (✓) Disapproved ( )

Remarks

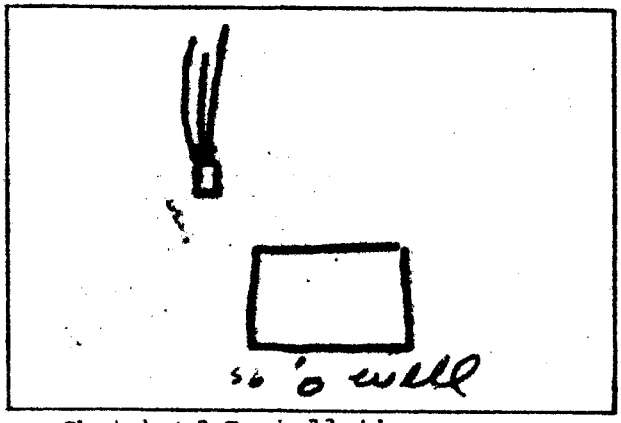

Sketch of Installation

Sanitarian