IREDELL COUNTY HEALTH DEPARTMENT

STATESVILLE 704-878-5305 MOORESVILLE 704-664-5281

IMPROVEMENT PERMIT / AUTHORIZATION TO CONSTRUCT / OPERATION PERMIT / EXISTING SYSTEM INSPECTION

PERMIT# 107661 PIN# 4769-41-9459 DATE 7-18-02

OWNER OR CONTRACTOR GARY HANCE PHONE: Business Home 704-546-2994

ADDRESS 136 LESPEDEZA LANE HARMONY NC 28634

LOCATION US 21 NORTH, TL LESPEDEZA LANE, AT END ON RIGHT

SUBDIVISION BLOCK / SECTION LOT LOT AREA 1.00 ACRE SITE CLASS PS DESIGN FLOW 360 L.T.A.R. EXISTING

Septic Tank: 1500 Gallons: STB Date

Pump Tank: Gallons: PT Date

Pump Make: Model Serial No.

Nitrification Field: No Fields 1 Square Feet 720 Linear Feet 240

No Lines THREE Trench Width 36" Max Trench Bottom Depth Gravel Depth 12"

~~New System~~ ☐ Repair System Type: I (II) III IV V VI

System Description: CONVENTIONAL, GRAVITY

Repair System Description:

Maintenance Agreement Required: ☐ Yes ☑ No

~~House/Mod. Home~~ ~~Mobile Home~~ ☐ Business ☐ Other

No. Bedrooms 3 No. Bathrooms 2 No. Employees

☐ Slab ☑ Crawl Space ☐ Basement w/plumbing ☐ Basement wo/plumbing


Water Supply: ☐ Individual ☑ Public ☐ Community

Comments/Conditions:

Comments/Conditions: SYSTEM UNDERSIZED ACCORDING TO TODAY'S STANDARDS

INITIAL SITE SKETCH

AS BUILT SKETCH

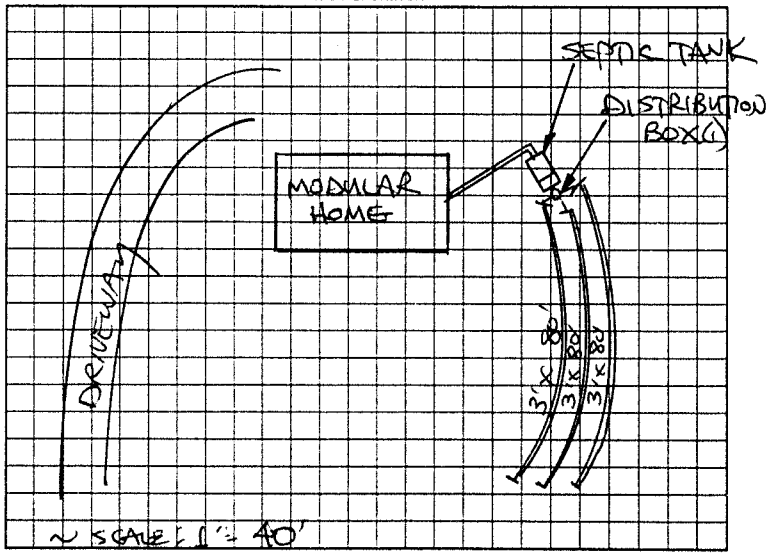

Permit can be suspended or revoked if any false information is supplied toward securing the permit/any unauthorized changes are made to the site/any unauthorized changes are made in the installation of the system. Improvement Permit with plat valid without expiration. Improvement Permit with site plan valid for sixty months. Authorization to Construct is valid for a period equal to that of Improvement Permit – not to exceed sixty months

Signed: date

Improvement Permit by: date

Authorization to Construct by: date

Installed by

Operation Permit by: date

Existing System Inspection by: STEVE HEDRICK date 7-18-02

HEALTH DEPT. COPY: WHITE OWNER COPY (FINAL): YELLOW OWNER COPY (INITIAL): PINK