IREDELL COUNTY HEALTH DEPARTMENT

STATESVILLE 704-878-5305 MOORESVILLE 704-664-5281

IMPROVEMENT PERMIT / AUTHORIZATION TO CONSTRUCT / OPERATION PERMIT / EXISTING SYSTEM INSPECTION

PERMIT# 108644 PIN# 4769 - 47 - 6058 DATE 9-10-02

OWNER OR CONTRACTOR FLEETWOOD HOMES OF STATESVILLE PHONE Business 704-872-0179 Home

ADDRESS 1270 NORTHSIDE DRIVE, STATESVILLE, NC 28625

LOCATION I-77 N, TR TOMLIN MILL RD, TR AT BOX #235, 0.4 MILE BACK OFF ROAD

SUBDIVISION BLOCK / SECTION LOT LOT AREA AMPLE SITE CLASS. PS DESIGN FLOW 480 L.T.A.R. 0.35 GPD/FT²

Septic Tank: EXISTING Gallons: STB Date

Pump Tank: Gallons: PT Date

Pump Make: Model Serial No.

Nitrification Field: No Fields 1 Square Feet 345 Linear Feet 115

No Lines ONE Trench Width 36" Max Trench Bottom Depth 36" Gravel Depth 12"

☐ New System ☐ Repair System Type: I II. IV. V. VI

System Description: CONVENTIONAL, GRAVITY

Repair System Description: 25% REDUCTION, GRAVITY

Maintenance Agreement Required: ☐ Yes ☐ No

☐ House/Mod. Home ☐ Mobile Home ☐ Business ☐ Other

No. Bedrooms 4 No. Bathrooms 2 No Employees


☐ Slab ☐ Crawl Space ☐ Basement w/plumbing ☐ Basement wo/plumbing

Water Supply: ☑ Individual ☐ Public ☐ Community WELL

Comments/Conditions: REPLACE EXISTING DISTRIBUTION BOX WITH SERIES OF FOUR (4) DROP BOXES FOR SERIAL DISTRIBUTION AS SHOWN ② INSTALL NEW 3'x 115' LINE ON CONTOUR AS FLAGGED

Comments/Conditions:

INITIAL SITE SKETCH

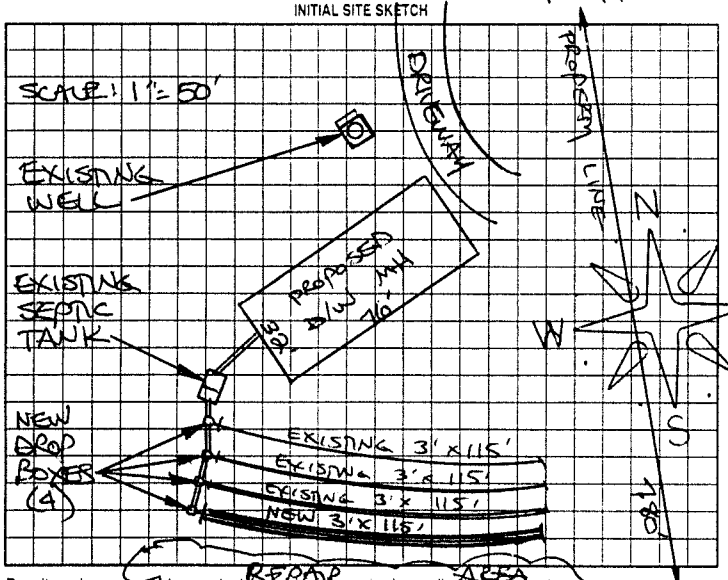

AS BUILT SKETCH

INSTALLED AS SHOWN IN INITIAL SITE SKETCH

Permit can be suspended or revoked if any false information is supplied toward securing the permit/any unauthorized changes are made to the site/any unauthorized changes are made in the installation of the system. Improvement Permit with plat valid without expiration. Improvement Permit with site plan valid for sixty months. Authorization to Construct is valid for a period equal to that of Improvement Permit – not to exceed sixty months.

Signed: date 9/13/02 Installed by: JOEL CHURCH

Improvement Permit by: STEVE HENDRICK date 9-10-02 Operation Permit by: date 09/20/02

Authorization to Construct by: STEVE HENDRICK date 9-10-02 Existing System Inspection by: date

HEALTH DEPT. COPY WHITE OWNER COPY (FINAL) YELLOW OWNER COPY (INITIAL) PINK