THIS PERMIT VOIDS PREVIOUS ISSUED 11-14-02

IREDELL COUNTY HEALTH DEPARTMENT

STATESVILLE 704-878-5305 (C1) MOORESVILLE 704-664-5281

IMPROVEMENT PERMIT / AUTHORIZATION TO CONSTRUCT / OPERATION PERMIT / EXISTING SYSTEM INSPECTION

PERMIT# 109663 PIN# 4769-50-6028 DATE 12-20-02

OWNER OR CONTRACTOR ALAN SPEER PHONE: Business 704-880-5622 Home 704-876-2979

ADDRESS 2622 S. CHIPLEY FORD, STATESVILLE, NC 28625

LOCATION US 21 NORTH, CROSS ROCKY CREEK, 1ST ON RIGHT PAST "OLD 21" AT ROCKY CREEK

SUBDIVISION _____ BLOCK / SECTION _____ LOT _____ LOT AREA 23.379 ACRES SITE CLASS P3 DESIGN FLOW 360 L.T.A.R. 0.40 GPD/FT²

Septic Tank: 1000 Gallons: STB 1007 Date 9-5-02
Pump Tank: _____ Gallons: PT _____ Date _____
Pump Make: _____ Model _____ Serial No. _____
Nitrification Field: No Fields 1 Square Feet 900 Linear Feet 300
No Lines THREE Trench Width 36" Max Trench Bottom Depth 30"

☑ New System ☐ Repair System Type: I (II) III. IV. V. VI
System Description: CONVENTIONAL GRAVITY
Repair System Description: LOW PRESSURE PIPE
Maintenance Agreement Required: ☐ Yes ☑ No
Gravel Depth 12" ☐ Slab ☑ Crawl Space ☐ Basement w/plumbing ☐ Basement wo/plumbing

☐ House/Mod. Home No. Bedrooms 3
☑ Mobile Home No. Bathrooms 2
☐ Business No. Employees _____
☐ Other _____


Water Supply: ☑ Individual ☑ Public ☐ Community

Comments/Conditions: INSTALL LINES NO DEEPER THAN 30"

Comments/Conditions: SEPTIC TANK WITH MARKER INSTALLED USING "BUYLOK" FILTER

SCALE: 1"=40'

INITIAL SITE SKETCH

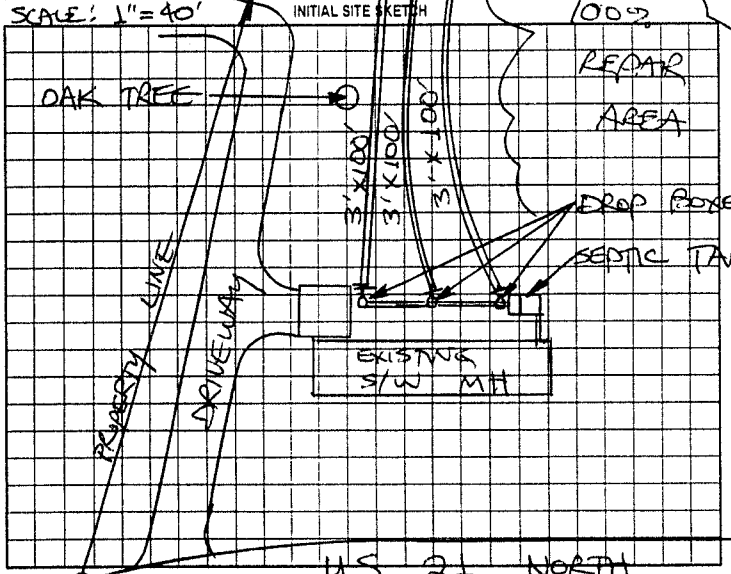

AS BUILT SKETCH

SYSTEM INSTALLED ACCORDING TO INITAL SITE SKETCH

Permit can be suspended or revoked if any false information is supplied toward securing the permit/any unauthorized changes are made to the site/any unauthorized changes are made in the installation of the system. Improvement Permit with plat valid without expiration. Improvement Permit with site plan valid for sixty months. Authorization to Construct is valid for a period equal to that of Improvement Permit – not to exceed sixty months

Signed: Alan Speer date 12-20-02 Installed by: JAMES HUPLER

Improvement Permit by: STEVE HENDRICK date 12-20-02 Operation Permit by: STEVE HENDRICK date 12-30-02

Authorization to Construct by: STEVE HENDRICK date 12-20-02 Existing System Inspection by: _____ date _____

HEALTH DEPT. COPY: WHITE OWNER COPY (FINAL): YELLOW OWNER COPY (INITIAL): PINK