IREDELL COUNTY HEALTH DEPARTMENT

STATESVILLE 704-878-5305 MOORESVILLE 704-664-5281

IMPROVEMENT PERMIT / CERTIFICATE OF COMPLETION / OPERATION PERMIT / EXISTING SYSTEM INSPECTION

PROPERTY DESCRIPTION NO. 18550 DATE 6/14/94 TAX MAP NO. 12G-A-25A Watershed: ☐ Yes ☒ No

OWNER OR CONTRACTOR JACK CELNIK PHONE: Business Home (704) 327-0409

ADDRESS 1335 12 ST DR N.W, HICKORY, NC 28601

LOCATION US 21 N, CROSS ROCKY CREEK BRIDGE, TL PRIVATE DRIVE, BEAR (R), BACK OFF ROAD

SUBDIVISION BLOCK / SECTION LOT LOT AREA 3.00 AC SITE CLASS P5 DESIGN FLOW 240 L.T.A.R. 0.336 GPD/FT²

Septic Tank: 1000 Gallons: STB 1012 Date 9-31-95

Pump Tank: Gallons: PT Date

Pump Make: Model Serial No.

Nitrification Field: No Fields 1 Square Feet 720 Linear Feet 240

No Lines 3 Trench Width 36 Max Trench Bottom Depth 24

☒ New System ☐ Repair System Type: I (II), III, IV, V, VI

System Description: CONV. GRAVITY

Repair System Description: CONV. GRAVITY

Maintenance Agreement Required: ☐ Yes ☒ No

Gravel Depth 12" ☐ Slab ☒ Crawl Space ☐ Basement w/plumbing ☐ Basement wo/plumbing

☒ House/Mod. Home No. Bedrooms 1

☐ Mobile Home No. Bathrooms 1

☐ Business No. Employees


☐ Other

Water Supply:
☒ Individual
☐ Community
☒ Public

Comments: ① KEEP SYSTEM MINIMUM 5' FROM HOUSE, 100' FROM ANY WELL ② INSTALL LINES ON CONTOUR, NO DEEPER THAN 24", 9' APART ON CENTER.

Comments: INSTALLED MADE UNAUTHORIZED CHANGES IN THE INSTALLATION OF DRAINLINES, APPROVED AFTER THE FACT BY RSH.

INITIAL SITE SKETCH

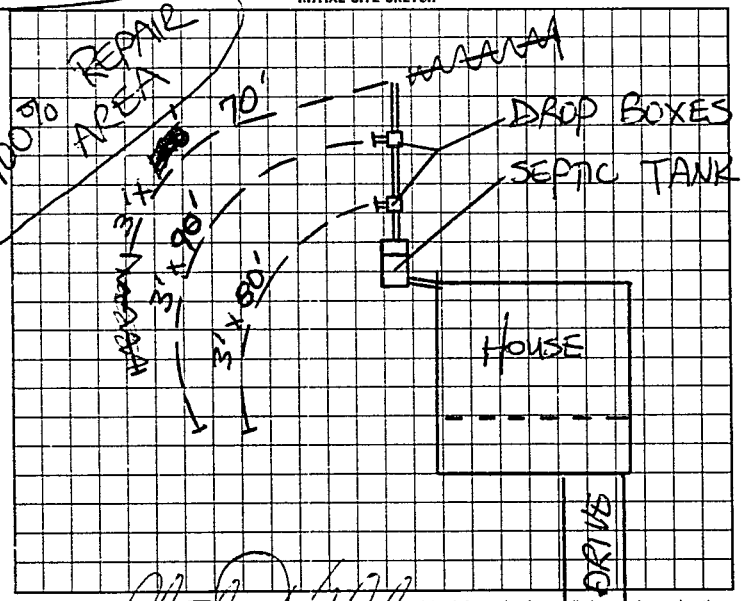

AS BUILT SKETCH

SYSTEM INSTALLED AS SHOWN ON INITAL SITE SKETCH

I understand that this permit can be suspended or revoked if any false information is supplied toward securing the permit/any unauthorized changes are made to the site/any unauthorized changes are made in the installation of the system. Improvement Permit is valid for 60 months from date of issuance.

Signed: STEVE HEDRICK

Improvement Permit by: STEVE HEDRICK date 6/14/94

Existing System Inspection by: date

Installed by: TOMMY FRYE

Certificate of Completion by: date

Operation Permit by: STEVE HEDRICK date 1-3-96

HEALTH DEPT. COPY: WHITE INSPECTION COPY (FINAL): GREEN OWNER COPY (FINAL): YELLOW INSPECTION COPY (INITIAL): PINK OWNER COPY (INITIAL): GOLD

L 98200