IREDELL COUNTY HEALTH DEPARTMENT

STATESVILLE 704-878-5305 MOORESVILLE 704-664-5281

IMPROVEMENT PERMIT / AUTHORIZATION TO CONSTRUCT / OPERATION PERMIT / EXISTING SYSTEM INSPECTION

PERMIT# REPAIR PIN# 4769-62-7226 DATE 2-6-02

OWNER OR CONTRACTOR PATRICK WALDRON PHONE: Business Home (704) 546-7295

ADDRESS 2463 TURNERSBURG HWY, TURNERSBURG, NC 28688

LOCATION US 21 NORTH CROSS ROCKY CREEK, HOUSE ON LEFT AT BOX # 2463

SUBDIVISION BLOCK / SECTION LOT LOT AREA 7.02 ACRES SITE CLASS PS DESIGN FLOW 600 L.T.A.R. EXISTING

Septic Tank: 1500 Gallons; STB 268 Date 12-27-01
Pump Tank: Gallons; PT Date
Pump Make: Model Serial No.
Nitrification Field: No Fields 1 Square Feet 1800 Linear Feet 600
No Lines FOUR Trench Width 36" Max Trench Bottom Depth ~36" Gravel Depth 12"

☐ New System ☑ Repair System Type: I II III IV V VI
System Description: CONVENTIONAL GRAVITY
Repair System Description: CONVENTIONAL GRAVITY
Maintenance Agreement Required: ☐ Yes ☑ No
☐ Slab ☐ Crawl Space ☑ Basement w/plumbing ☐ Basement wo/plumbing


☑ House/Mod. Home No. Bedrooms 5
☐ Mobile Home No. Bathrooms
☐ Business No. Employees
☐ Other TWO HOUSES

Water Supply: ☐ Individual ☑ Public ☐ Community

Comments/Conditions:

Comments/Conditions: SEPTIC TANK WITH RISERS INSTALLED USING "POLYLOK" FILTER

INITIAL SITE SKETCH

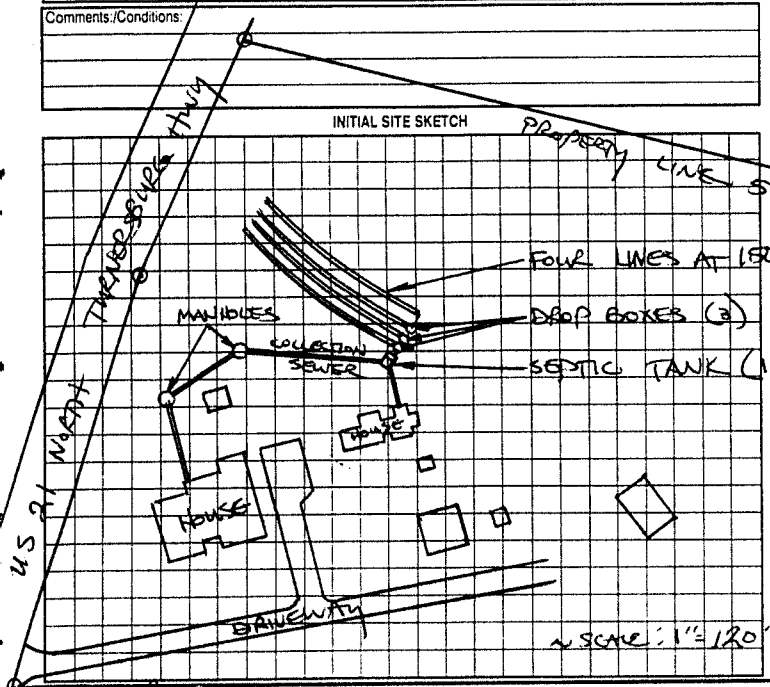

AS BUILT SKETCH

SYSTEM REPAIRED ACCORDING TO INITIAL SITE SKETCH

Permit can be suspended or revoked if any false information is supplied toward securing the permit/any unauthorized changes are made to the site/any unauthorized changes are made in the installation of the system. Improvement Permit with plan valid without expiration. Improvement Permit with site plan valid for sixty months. Authorization to Construct is valid for a period equal to that of Improvement Permit – not to exceed sixty months.

Signed: Patrick Waldron date 2-6-2002

Improvement Permit by: STEVE HEDRICK date 2-6-02

Authorization to Construct by: STEVE HEDRICK date 2-6-02

Installed by: JAMES HUDLER

Operation Permit by: STEVE HEDRICK date 2-19-02

Existing System Inspection by: date

HEALTH DEPT COPY WHITE OWNER COPY (FINAL) YELLOW OWNER COPY (INITIAL) PINK