IREDELL COUNTY HEALTH DEPARTMENT (CI | LF)

STATESVILLE 704-878-5305 MOORESVILLE 704-664-5281

IMPROVEMENT PERMIT / AUTHORIZATION TO CONSTRUCT / OPERATION PERMIT / EXISTING SYSTEM INSPECTION

PERMIT# 11696 PIN# 4765-66-0824 DATE 11-4-03

OWNER OR CONTRACTOR NORMAN & DORINDA DUDLEY PHONE: Business 704-528-7120 Home

ADDRESS 139 SANFORD DR OLIN NC 28660

LOCATION 21 N, @ TABOR @ SANFORD ATEW BEHIND HOUSE ON LEFT

SUBDIVISION BLOCK / SECTION LOT LOT AREA 1.43 AC SITE CLASS B DESIGN FLOW 240 L.T.A.R. 1.3

Septic Tank: 1000 Gallons; STB 1012 Date 5-5-03

Pump Tank: Gallons; PT Date

Pump Make: Model Serial No.

Nitrification Field: No Fields 1 Square Feet 36" Linear Feet 270'

No Lines 3x90' Trench Width 36" Max Trench Bottom Depth 36" Gravel Depth 12"

☒ New System ☐ Repair System Type: I, (II), III, IV, V, VI

System Description: CONV 60W

Repair System Description: SAME

Maintenance Agreement Required: ☐ Yes ☒ No

☒ House/Mod. Home ☒ Mobile Home ☐ Business ☐ Other

No. Bedrooms 2 No. Bathrooms 2 No. Employees


☐ Slab ☒ Crawl Space ☐ Basement w/plumbing ☐ Basement wo/plumbing

Water Supply: ☒ Individual ☐ Public ☐ Community


Comments/Conditions: (1) INSTALL LINES ON CONTOURS (2) MAINTAIN SETBACKS

Comments/Conditions: TUFFTITE FILTER & MANIFOLD INSTALLED AS DRAWN

INITIAL SITE SKETCH NOT TO SCALE

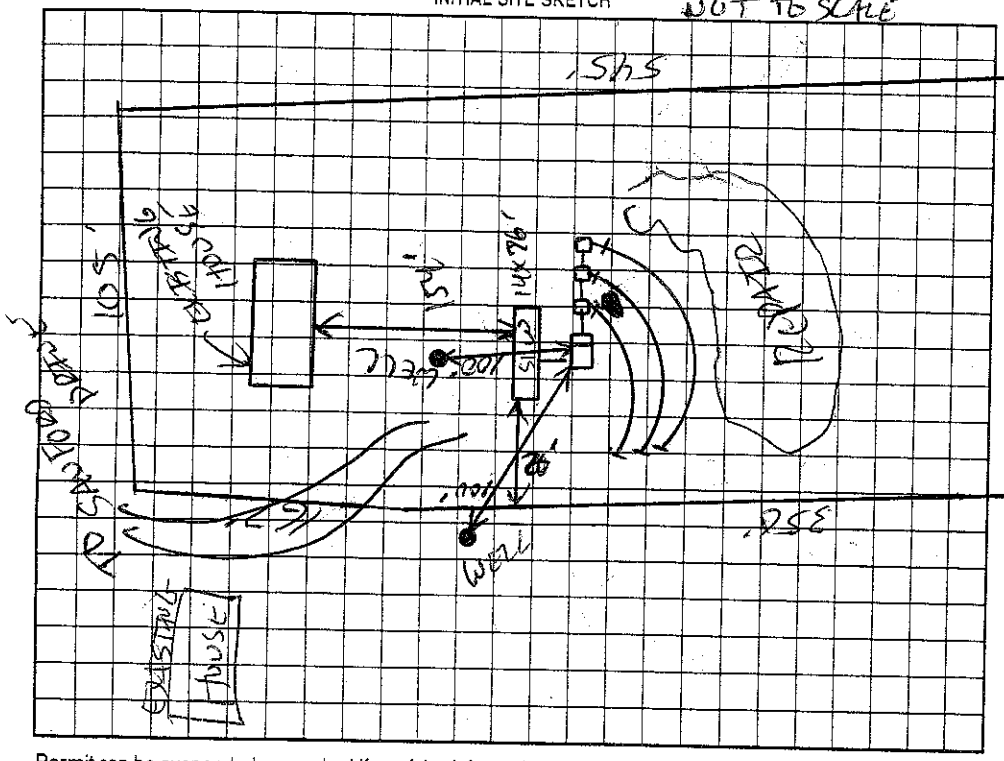

AS BUILT SKETCH

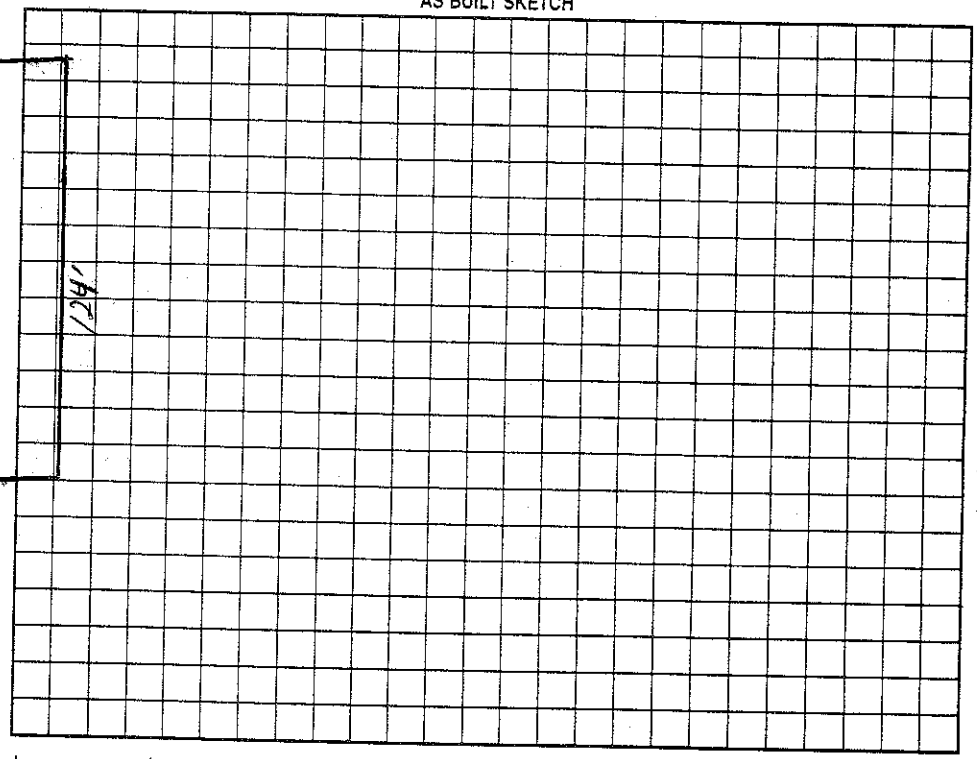

Permit can be suspended or revoked if any false information is supplied toward securing the permit/any unauthorized changes are made to the site/any unauthorized changes are made in the installation of the system. Improvement Permit with plat valid without expiration. Improvement Permit with site plan valid for sixty months. Authorization to Construct is valid for a period equal to that of Improvement Permit – not to exceed sixty months.

Signed: date 11/4/03 Installed by: CRAIG THOMPSON

Improvement Permit by: date 11-4-03 Operation Permit by: date 11-4-03

Authorization to Construct by: date 11-4-03 Existing System Inspection by: date

HEALTH DEPT. COPY: WHITE OWNER COPY (FINAL): YELLOW OWNER COPY (INITIAL): PINK