4543 12G-1-A-4.7

IREDELL COUNTY HEALTH DEPARTMENT

STATESVILLE 704-878-5305 MOORESVILLE 704-664-5281

IMPROVEMENT PERMIT / CERTIFICATE OF COMPLETION / OPERATION PERMIT / EXISTING SYSTEM INSPECTION

PROPERTY DESCRIPTION NO. 1536 DATE 6/11/93 TAX MAP NO. 12G-1-A Pt 3 4.45

OWNER OR CONTRACTOR MICHAEL A & WILMA J. JAMES PHONE: Business Home 546-2248

ADDRESS RT. 1 Box 176 HARMONY NC 28634

LOCATION US 21 N, TL TABOR ROAD, JUST PAST HENKLE FARM ROAD. SUBDIVISION HARMONY HILLS BLOCK / SECTION LOT 3-7 LOT AREA AMPLE SITE CLASS. P3 L.T.A.R. 0.40 GPD/SF

Water Supply: ☑ Individual ☐ Community ☐ Public

Septic Tank: 1000 Gallons: STB 928 Date 5/14/93

Pump Tank: Gallons: PT Date

Nitrification Field: No Fields 1 Square Feet 900 Linear Feet 300

No. Lines 3 Trench Width 36" Trench Depth 36" Gravel Depth 12"

☑ New System ☐ Repair System Type: I, II, III, IV, V, VI

System Description: CONV. GRAVITY

Repair System Description: CONV. GRAVITY

Maintenance Agreement Required: ☐ Yes ☑ No

☑ House/Mod. Home ☐ Mobile Home ☐ Business ☐ Other

No. Bedrooms 3/2 No. Bathrooms No. Employees

Garbage Disposal: ☐ Yes ☑ No

Auto. Dishwasher: ☐ Yes ☐ No

Auto. Washing Machine: ☑ Yes ☐ No


Other

☐ Slab ☑ Crawl Space ☐ Basement w/plumbing ☐ Basement wo/plumbing

Comments

INITIAL SITE SKETCH

AS BUILT SKETCH

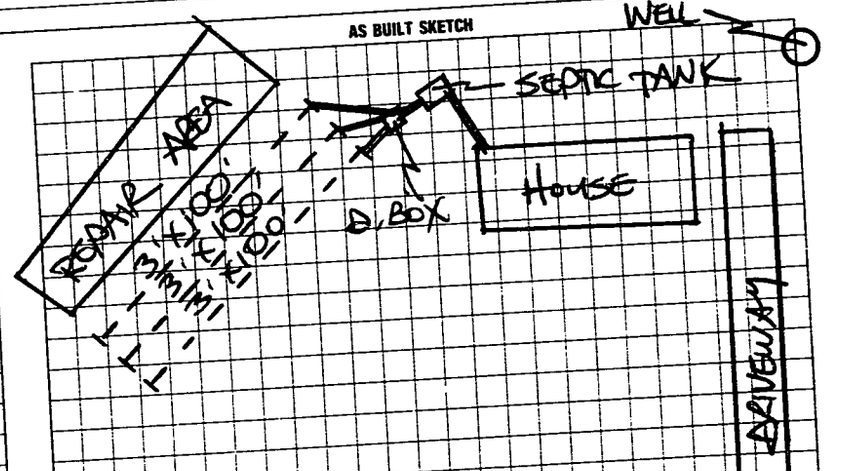

I understand that this permit can be suspended or revoked if any false information is supplied toward securing the permit/any unauthorized changes are made to the site/any unauthorized changes are made in the installation of the system. Improvement Permit is valid for 60 months from date of issuance.

Signed: Improvement Permit by: STEVE HENDRICK date 10/22/92

Existing System Inspection by: date

Installed by: SAMMY BEALS

Certificate of Completion by: STEVE HENDRICK date 6/11/93

Operation Permit by: date

HEALTH DEPT. COPY: WHITE INSPECTION COPY (FINAL): GREEN OWNER COPY (FINAL): YELLOW INSPECTION COPY (INITIAL): PINK OWNER COPY (INITIAL): GOLD

J