REDELL COUNTY HEALTH DEPARTMENT

Statesville Office (704) 878-5305 Mooresville Office (704) 660-3625 PERMIT # 206822

IMPROVEMENT PERMIT / AUTHORIZATION TO CONSTRUCT / OPERATION PERMIT / EXISTING SYSTEM

PIN # 4769670602

APPLICANT: Ben Shelton APPLICANT ADDRESS: 178 Helston Ln Olin NC 28660

PHONE: 704-881-5607 ALT. PHONE: 704-928-5877

SITE ADDRESS: 129 Worm Ln Olin NC 28660

SITE DIRECTIONS: N on 21 T/L Taber for apprex 1 mile T/L Worm Ln on left

SUBDIVISION: N/A SECTION: N/A LOT # N/A LOT AREA: 25.089ac DESIGN FLOW: 240 L.T.A.R.: 0.25

Septic Tank 1000 (gal) STB 760 Date 9-21-14

Pump Tank N/A (gal) PT N/A Date N/A

Pump Make N/A Model Polylok Serial # PL-68

Nitrification Fields 1 # Lines 2 Linear Ft: 240

Trench Width 36" Max. Trench Bottom Depth 36" Gravel Depth N/A

☒ New System ☐ Repair ☐ Expansion System Type: I II III IV V VI

System Description: 25% Reduction

Repair System Description: 25% Reduction

Maintenance Agreement Required: ☐ YES ☒ NO

☐ GRAVITY ☐ PRESSURE

☒ Residence ☐ Business ☐ Other ☐ Slab ☐ Basement w/plumbing


No. Bedrooms 2 No. Persons 4 No. Employees ☒ Crawl Space

Water Supply: ☐ Private ☒ Public ☐ Community


☐ Basement w/o plumbing

Comments / Conditions: Install 25% reduction on contour with Serial distribution

INITIAL SITE SKETCH

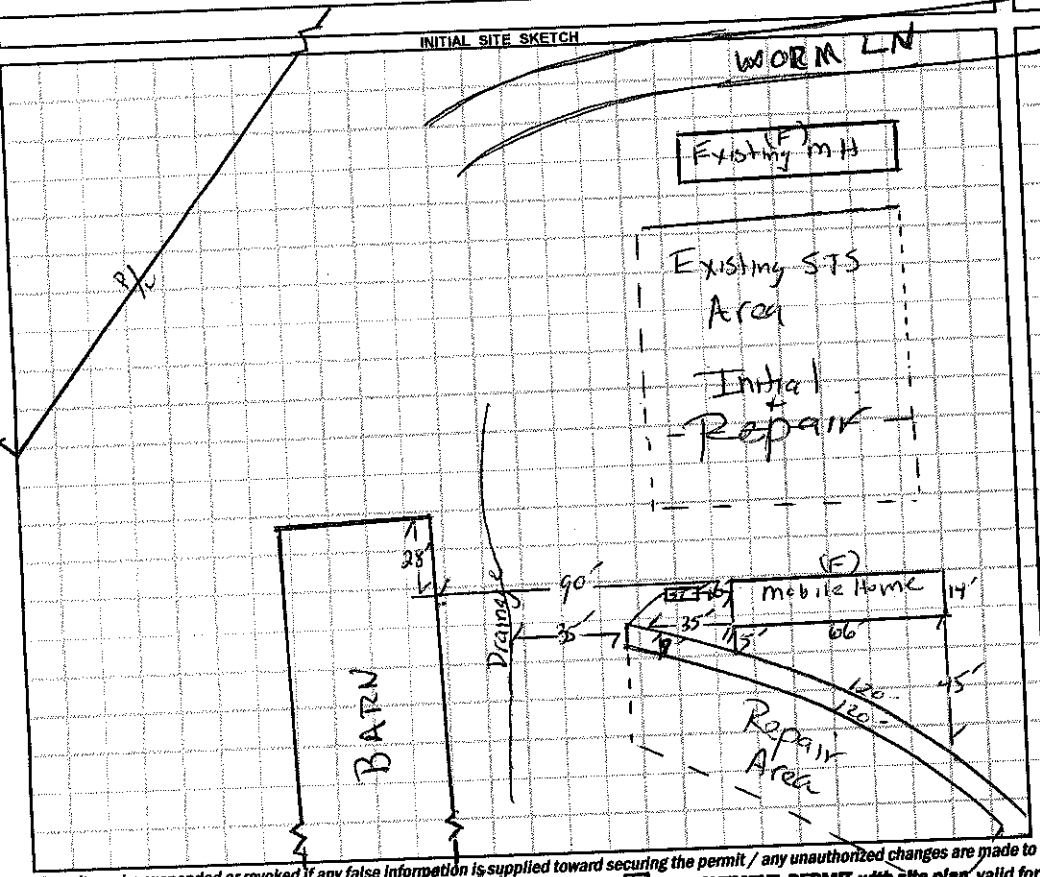

AS BUILT SKETCH

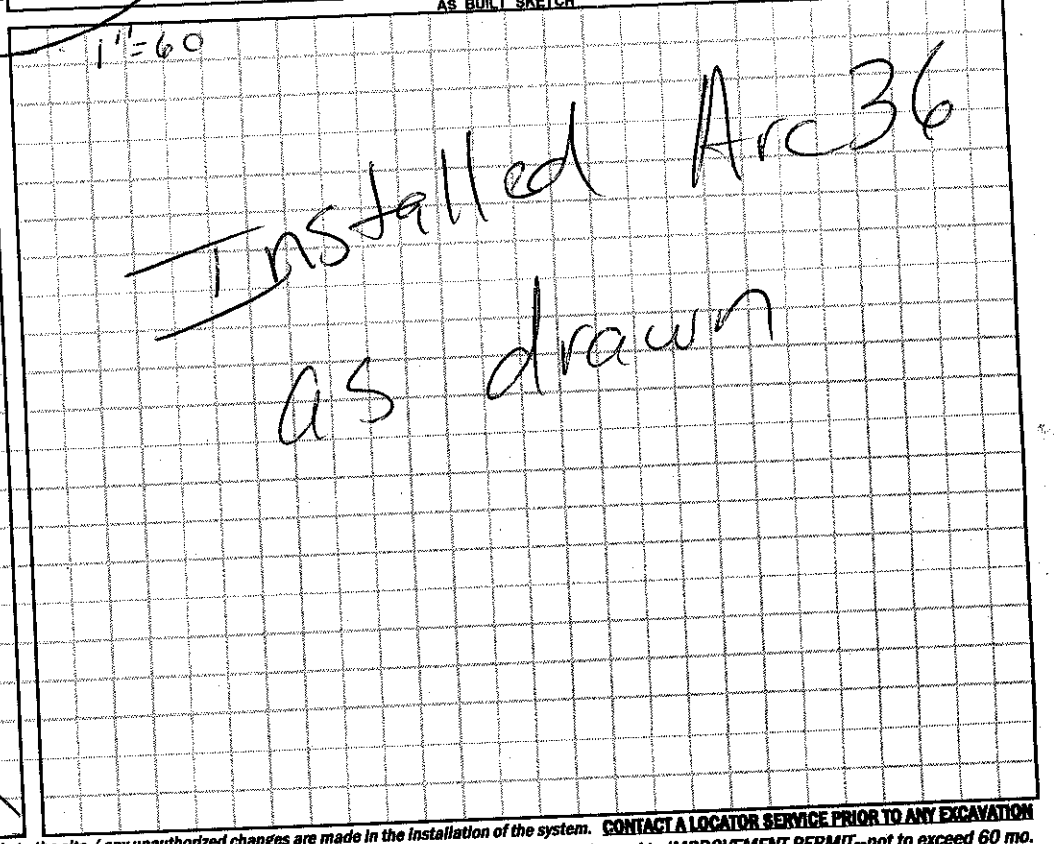

CONTACT A LOCATOR SERVICE PRIOR TO ANY EXCAVATION

Permit can be suspended or revoked if any false information is supplied toward securing the permit / any unauthorized changes are made to the site / any unauthorized changes are made in the installation of the system.

☐ IMPROVEMENT PERMIT *with plat* valid without expiration. ☒ IMPROVEMENT PERMIT *with site plan* valid for 60 mos. ☒ AUTHORIZATION TO CONSTRUCT valid for period equal to IMPROVEMENT PERMIT--not to exceed 60 mo.

Owner / Applicant Signature: Date: 1-8-15 Installed by: Abel's Excavating Date: 01/21/15

IMPROVEMENT PERMIT by: Date: 01/08/15 OPERATION PERMIT by: Date:

AUTHORIZATION TO CONSTRUCT by: Date: 01/08/15 Existing System Inspected by:

Health Dept. Copy - WHITE Applicant (Final Approval) - YELLOW Applicant (Conditional Approval) - PINK