IREDELL COUNTY HEALTH DEPARTMENT

STATESVILLE 704-878-5305 MOORESVILLE 704-664-5281 (21)

IMPROVEMENT PERMIT / AUTHORIZATION TO CONSTRUCT / OPERATION PERMIT / EXISTING SYSTEM INSPECTION

PERMIT# 105126 PIN# 4769-74-1505 DATE

OWNER OR CONTRACTOR PAUL HARMON PHONE: Business c/o 704-546-7417 Home 704-392-2935

ADDRESS 159 TABOR INN LANE, OLIN, NC 28660

LOCATION US 21N, TL TABOR ROAD, TL TABOR INN LANE, 1ST MH ON RIGHT

SUBDIVISION BLOCK / SECTION LOT LOT AREA LIMITED SITE CLASS. PS DESIGN FLOW 240 L.T.A.R. EXISTING

Septic Tank: EXISTING Gallons: STB Date
Pump Tank: Gallons: PT Date
Pump Make: Model Serial No.
Nitrification Field: No Fields ? Square Feet Linear Feet EXISTING
No Lines Trench Width Max Trench Bottom Depth Gravel Depth

☐ New System ☐ Repair System Type: I (II) III IV V VI
System Description: CONVENTIONAL GRAVITY
Repair System Description:
Maintenance Agreement Required: ☐ Yes ☑ No
☐ Slab ☑ Crawl Space ☐ Basement w/plumbing ☐ Basement wo/plumbing

☐ House/Mod. Home No. Bedrooms 2
☑ Mobile Home No. Bathrooms 1
☐ Business No. Employees
☐ Other


Water Supply: ☐ Individual ☑ Public ☐ Community

Comments:/Conditions:

Comments:/Conditions: SYSTEM WAS SIZED ACCORDING TO TODAY'S STANDARDS

INITIAL SITE SKETCH

AS BUILT SKETCH

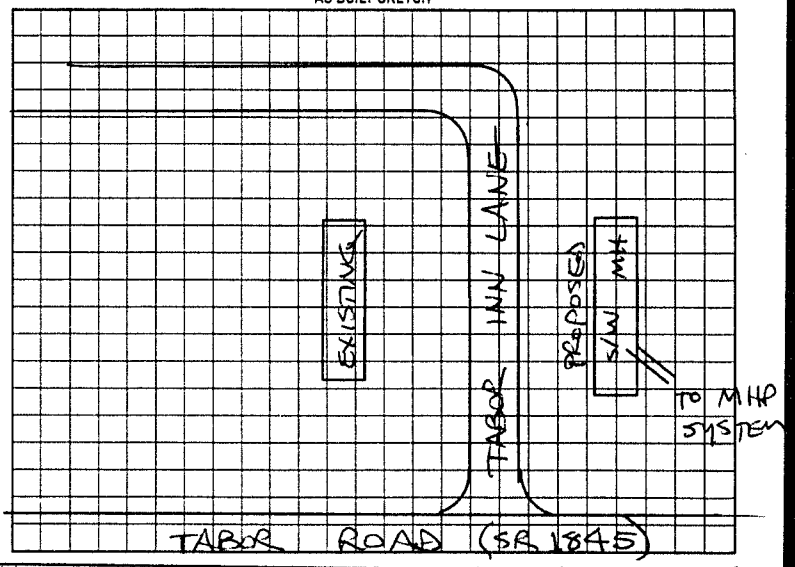

Permit can be suspended or revoked if any false information is supplied toward securing the permit/any unauthorized changes are made to the site/any unauthorized changes are made in the installation of the system. Improvement Permit with plat valid without expiration. Improvement Permit with site plan valid for sixty months. Authorization to Construct is valid for a period equal to that of Improvement Permit – not to exceed sixty months.

Signed: date Installed by:

Improvement Permit by: date Operation Permit by: date

Authorization to Construct by: date Existing System Inspection by: STEVE HEDRICK date 3-12-02

HEALTH DEPT COPY WHITE OWNER COPY (FINAL) YELLOW OWNER COPY (INITIAL) PINK